


Updated sheet 5 & 13 to AS-built
0.2_M.1

52.5" RAIL

MOUNT RAIL ON
THIRD LINK

XTFGA
GR1000
GRN/YEL
TERMINAL

4' X 5'

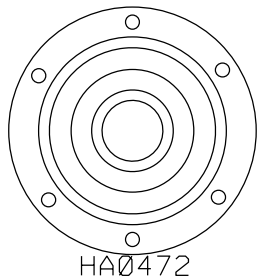

WARNING
LABEL

LIGHTNING
BOLT LABEL
NOT
REQUIRED
FOR 24VDC
SYSTEMS

NAME PLATE

52.5" RAIL

MOUNT RAIL ON
THIRD LINK

GR1100

SPRING
BOX : 1100321-4D741

7

8

THIS PRINT IS PROVIDED ON A RESTRICTED BASIS AND IS NOT TO BE USED
IN ANY WAY DETRIMENTAL TO SOLAR TURBINES INCORPORATED.

REVISION HISTORY


REV	DESCRIPTION	DATE	APPROVED
0	0	0	0
0.2		10/31/25	

CATERPILLAR CONFIDENTIAL GREEN

*THIS COPYRIGHTED WORK AND THE INFORMATION HEREIN IS PROPRIETARY TO CATERPILLAR INC., SOLAR TURBINES INCORPORATED, AND/OR SUBSIDIARIES OF
EITHER. WITHOUT EXPRESS WRITTEN PERMISSION FROM CATERPILLAR INC. OR SOLAR TURBINES INCORPORATED, ANY COPYING, DISCLOSURE, OR USE EXCEPT
THAT FOR WHICH IT IS LOANED, IS PROHIBITED.*



DATA CONTROL LEVEL 1	RELEASE STAMP PD- 4K391	SIZE D	CAGE NO. 66195		Solar Turbines <i>A Caterpillar Company</i> P.O. BOX 85376 San Diego, California 92186-5376	
		MFG DES ENGINEER	DATE	DRAWING TITLE TURBINE CONTROL JB70		
		DESIGN ENGINEER	DATE			
			10/31/2025			
PROJECT NAME Enterprise SMT130 M4 WTX					DWG NO. 4K391-2867628	SHT REV 0.0
MODEL CTLM02 TURBOTRONICS 4 LOC T:\PROJECT\LAYOUT\REV\					DWG REV 0.2	SHEET 1 OF 14

THIS PRINT IS PROVIDED ON A RESTRICTED BASIS AND IS NOT TO BE USED IN ANY WAY DETRIMENTAL TO SOLAR TURBINES INCORPORATED.			
REVISION HISTORY			
REV	DESCRIPTION	DATE	APPROVED
0	0	0	0
0.2		10/31/25	

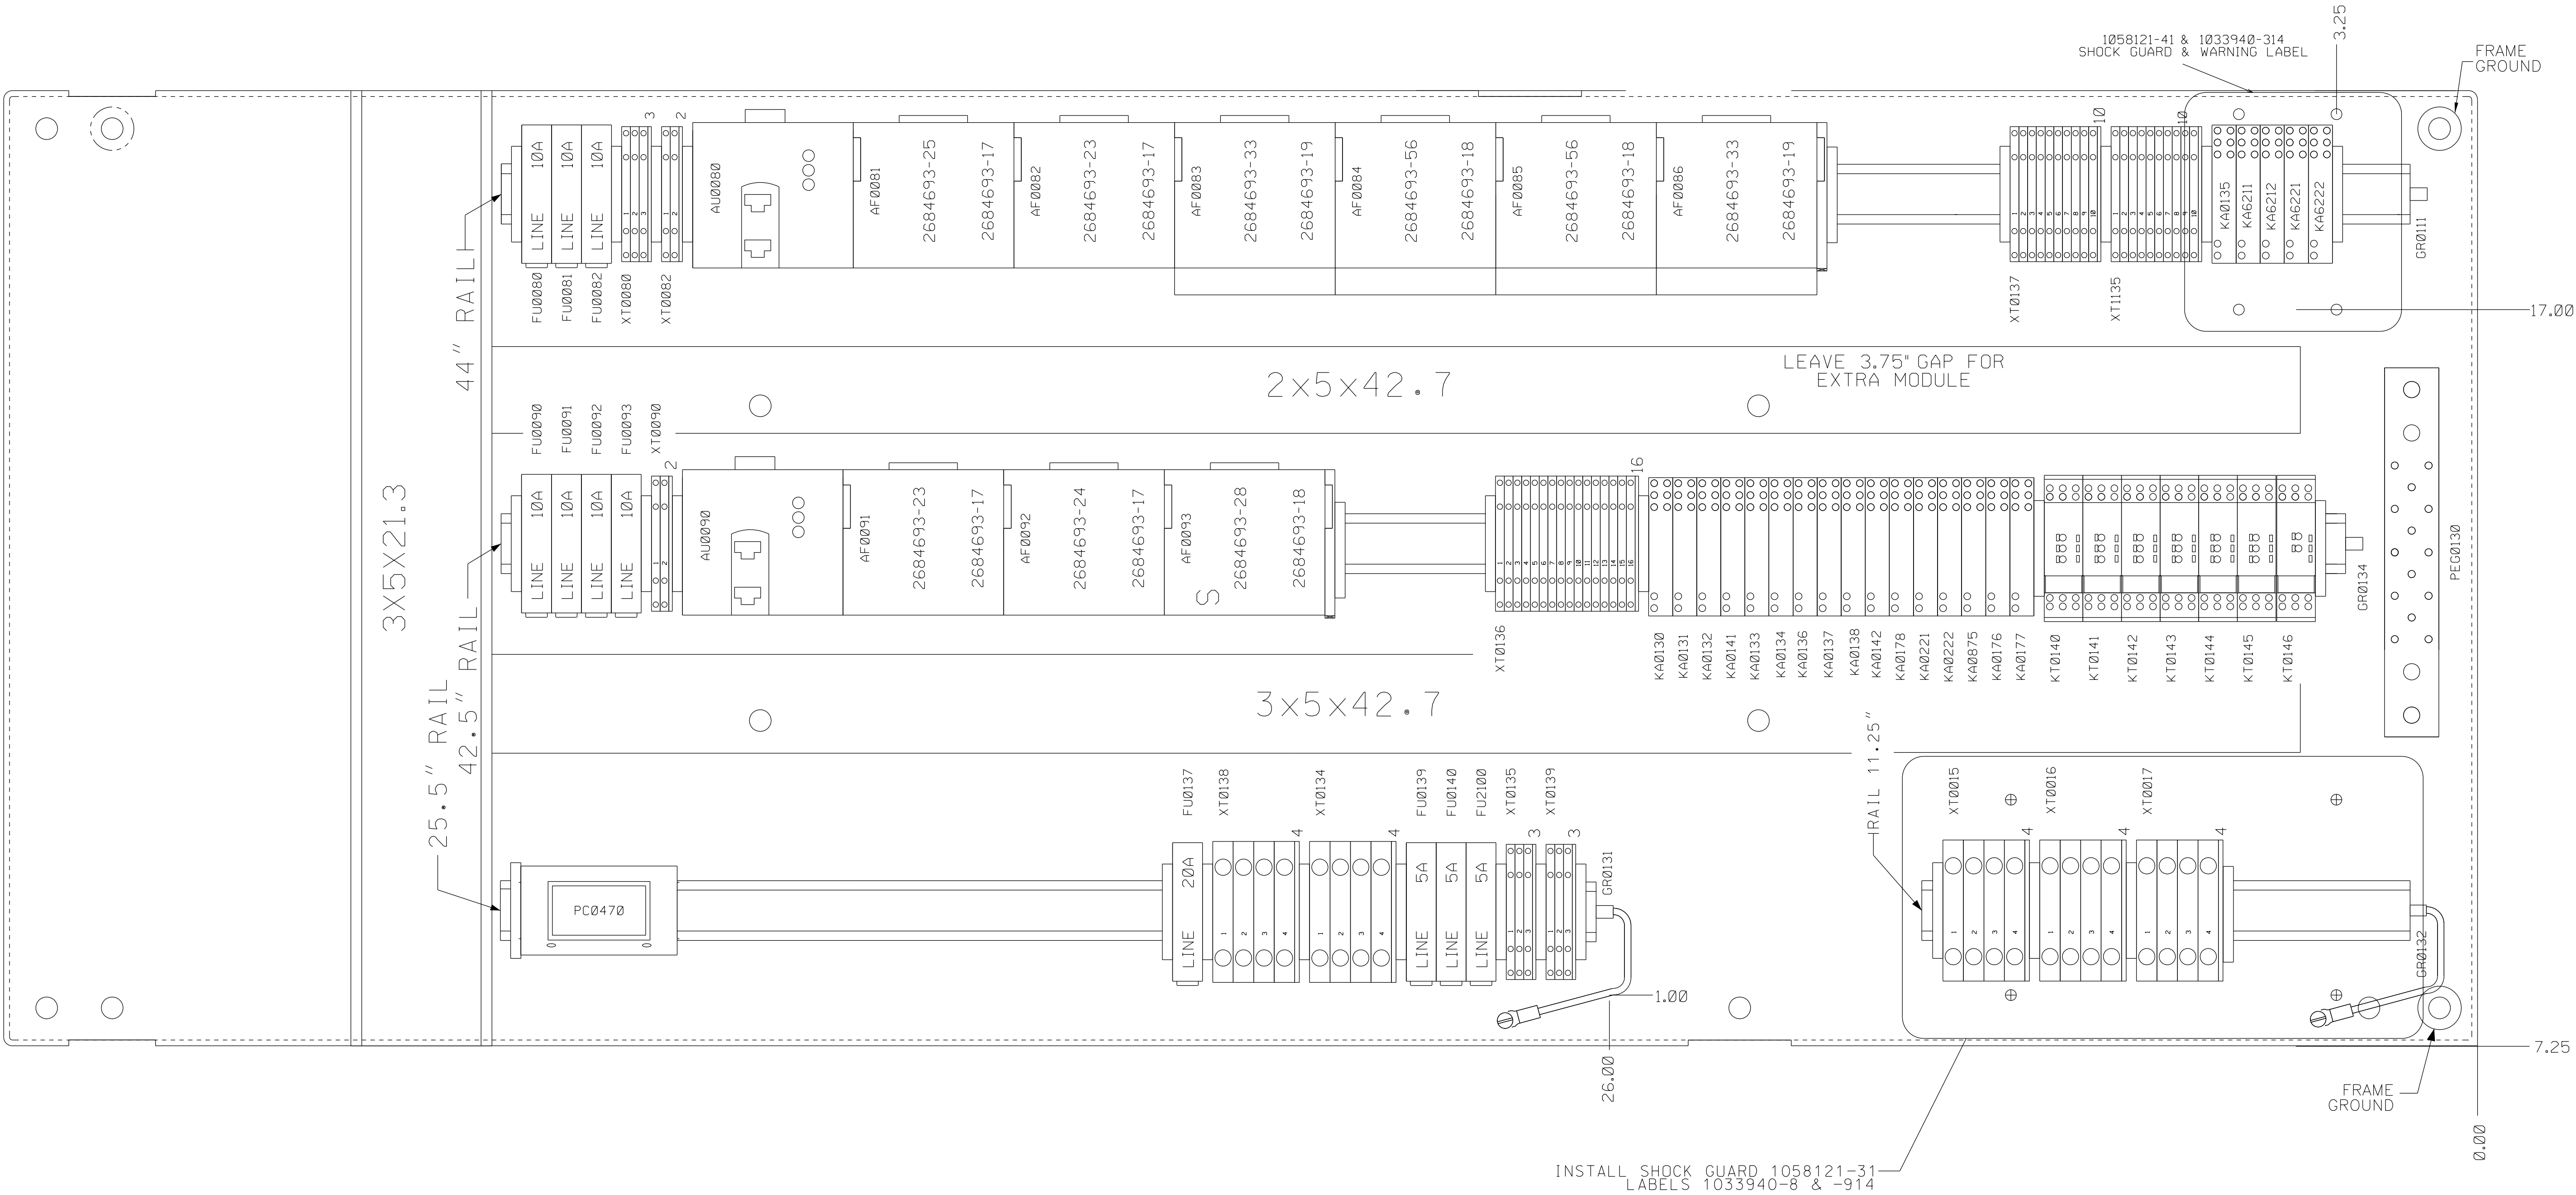

SPRING
BOX : 1100321-4D741
PANEL:1058112-314

CATERPILLAR CONFIDENTIAL GREEN						
THIS COPYRIGHTED WORK AND THE INFORMATION HEREIN IS PROPRIETARY TO CATERPILLAR INC., SOLAR TURBINES INCORPORATED, AND/OR SUBSIDIARIES OF EITHER. WITHOUT EXPRESS WRITTEN PERMISSION FROM CATERPILLAR INC. OR SOLAR TURBINES INCORPORATED, ANY COPYING, DISCLOSURE, OR USE EXCEPT THAT FOR WHICH IT IS LOANED, IS PROHIBITED.						
DATA CONTROL LEVEL 1	RELEASE STAMP PD- 4K391	SIZE D	CAGE NO. 66195	Solar Turbines <i>A Caterpillar Company</i>		P.O. BOX 85376 San Diego, California 92186-5376
		MFG DES ENGINEER	DATE 10/31/2025			
		DESIGN ENGINEER	DATE 10/31/2025			
		PROJECT NAME Enterprise SMT130 M4 WTX				
MODEL	CTLMO2 TURBOTRONICS 4			DWG NO. 4K391-2860508	SHT REV 0.0	
LOC	T:\PROJECT\LAYOUT\REV\			DWG REV 0.2	SHEET 2 OF 14	

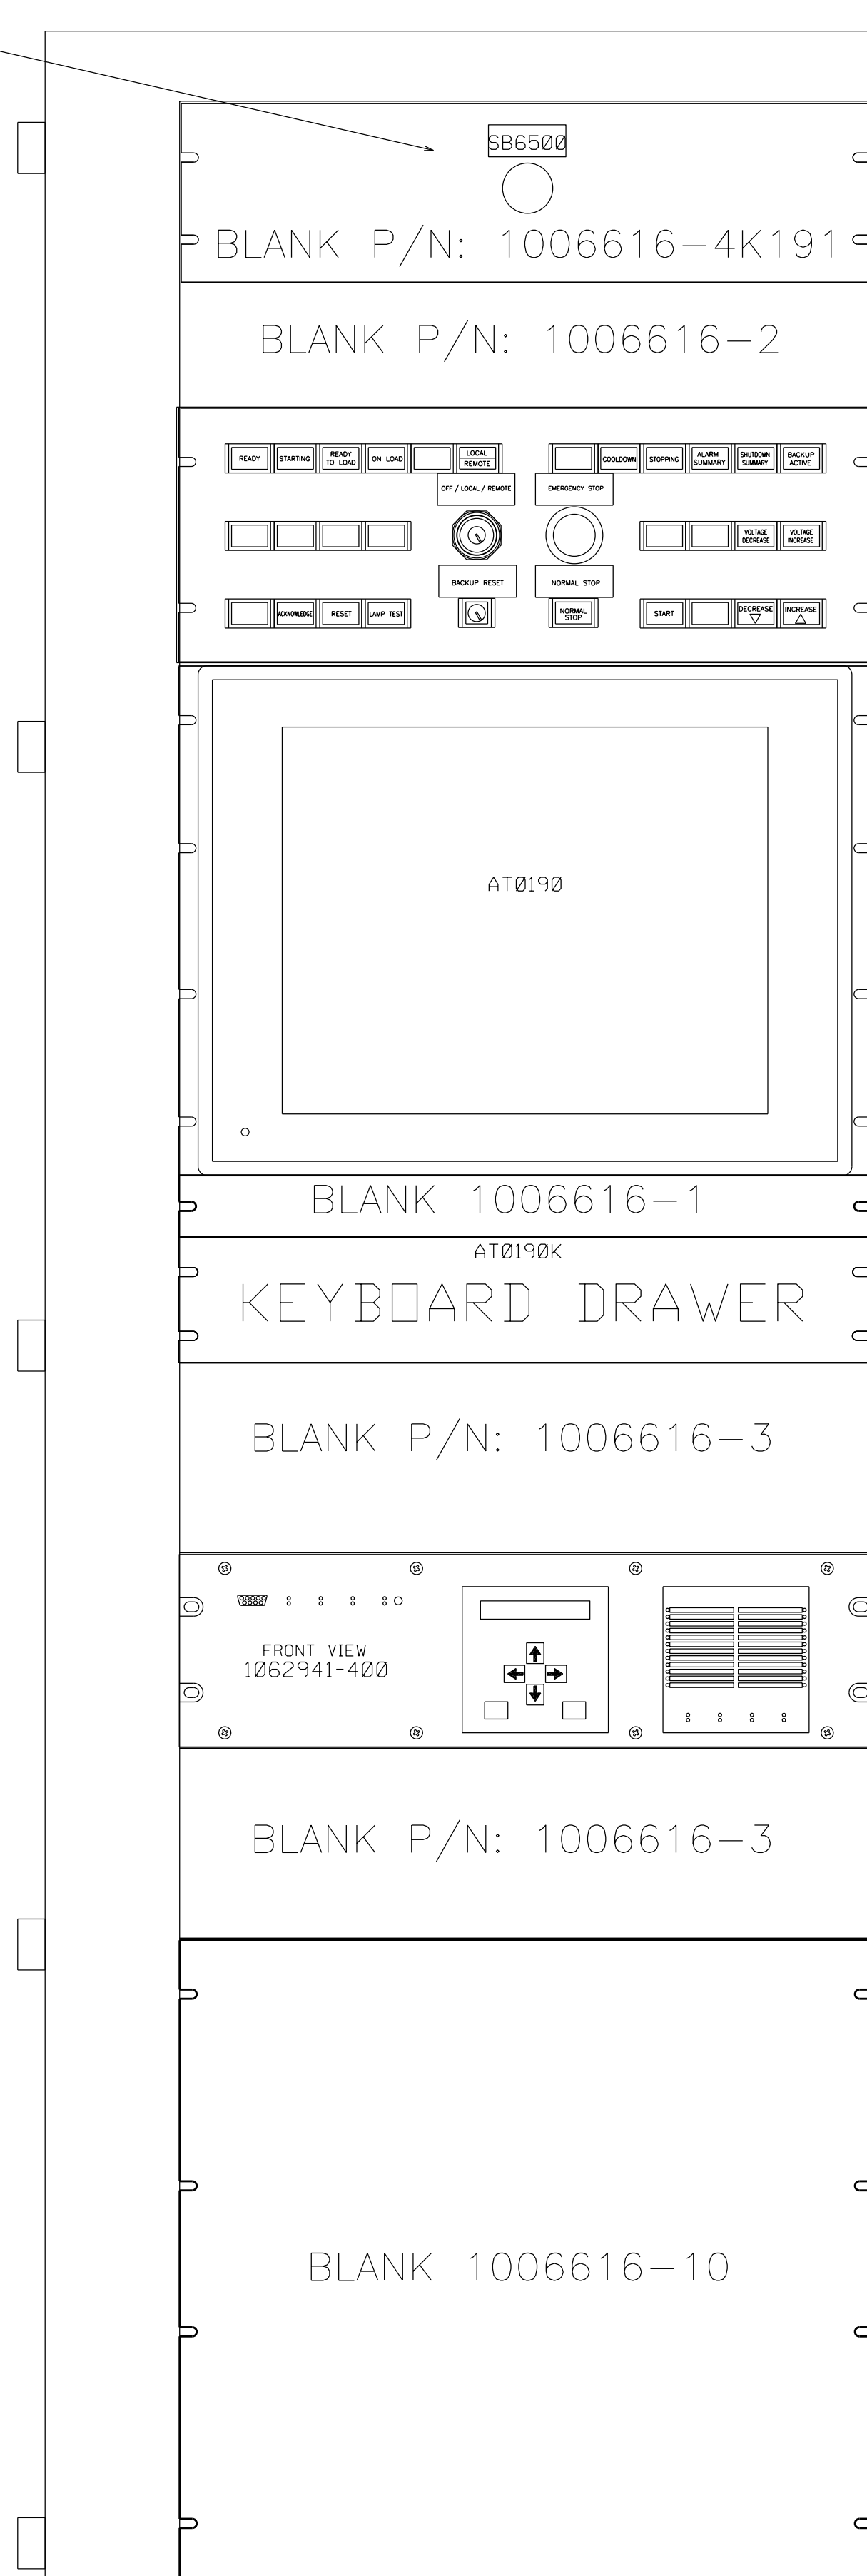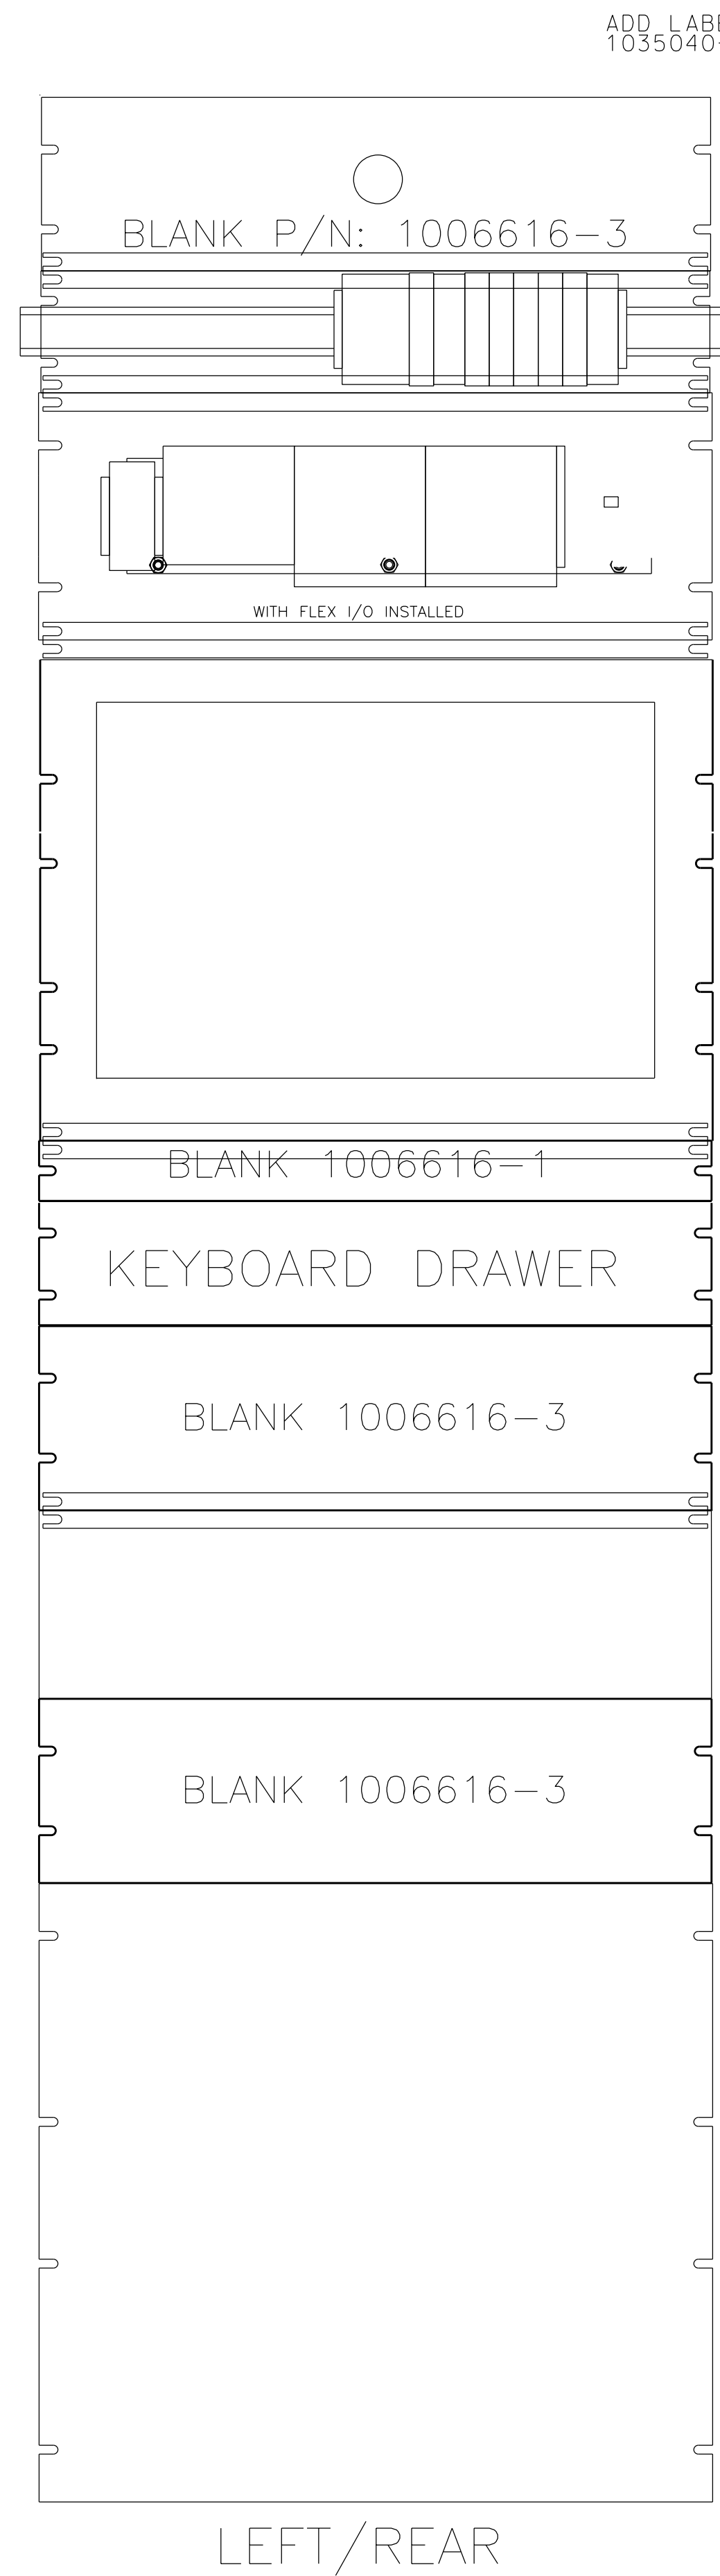


7		8	
THIS PRINT IS PROVIDED ON A RESTRICTED BASIS AND IS NOT TO BE USED IN ANY WAY DETRIMENTAL TO SOLAR TURBINES INCORPORATED.			
REVISION HISTORY			
REV	DESCRIPTION	DATE	APPROVED
0	0	0	0
0.2		10/31/25	

CATERPILLAR CONFIDENTIAL GREEN					
THIS COPYRIGHTED WORK AND THE INFORMATION HEREIN IS PROPRIETARY TO CATERPILLAR INC.. SOLAR TURBINES INCORPORATED, AND/OR SUBSIDIARIES OF EITHER, WITHOUT EXPRESS WRITTEN PERMISSION FROM CATERPILLAR INC. OR SOLAR TURBINES INCORPORATED, ANY COPYING, DISCLOSURE, OR USE EXCEPT THAT FOR WHICH IT IS LOANED, IS PROHIBITED."					
DATA CONTROL LEVEL 1	RELEASE STAMP PD - 4K391	SIZE D	CAGE NO. 66195	 A Caterpillar Company	P.O. BOX 85376 San Diego, California 92186-5376
		MFG DES ENGINEER	DATE 10/31/2025	DRAWING TITLE PNL,DOOR,2-BAY	
		DESIGN ENGINEER	DATE 10/31/2025		
	PROJECT NAME Enterprise SMT130 M4 WTX				
MODEL CTLMO2 TURBOTRONICS 4	DWG NO. 4K391-2864759			SHT REV 0.0	
LOC T:\PROJECT\LAYOUT\REV\	DWG REV 0.2			SHEET 4 OF 14	

THIS PRINT IS PROVIDED ON A RESTRICTED BASIS AND IS NOT TO BE USED IN ANY WAY DETRIMENTAL TO SOLAR TURBINES INCORPORATED.			
REVISION HISTORY			
REV	DESCRIPTION	DATE	APPROVED
0	0	0	0
0.2		10/31/25	

0.2_M.1 Frame ground shown to reflect as built.

01/21/26

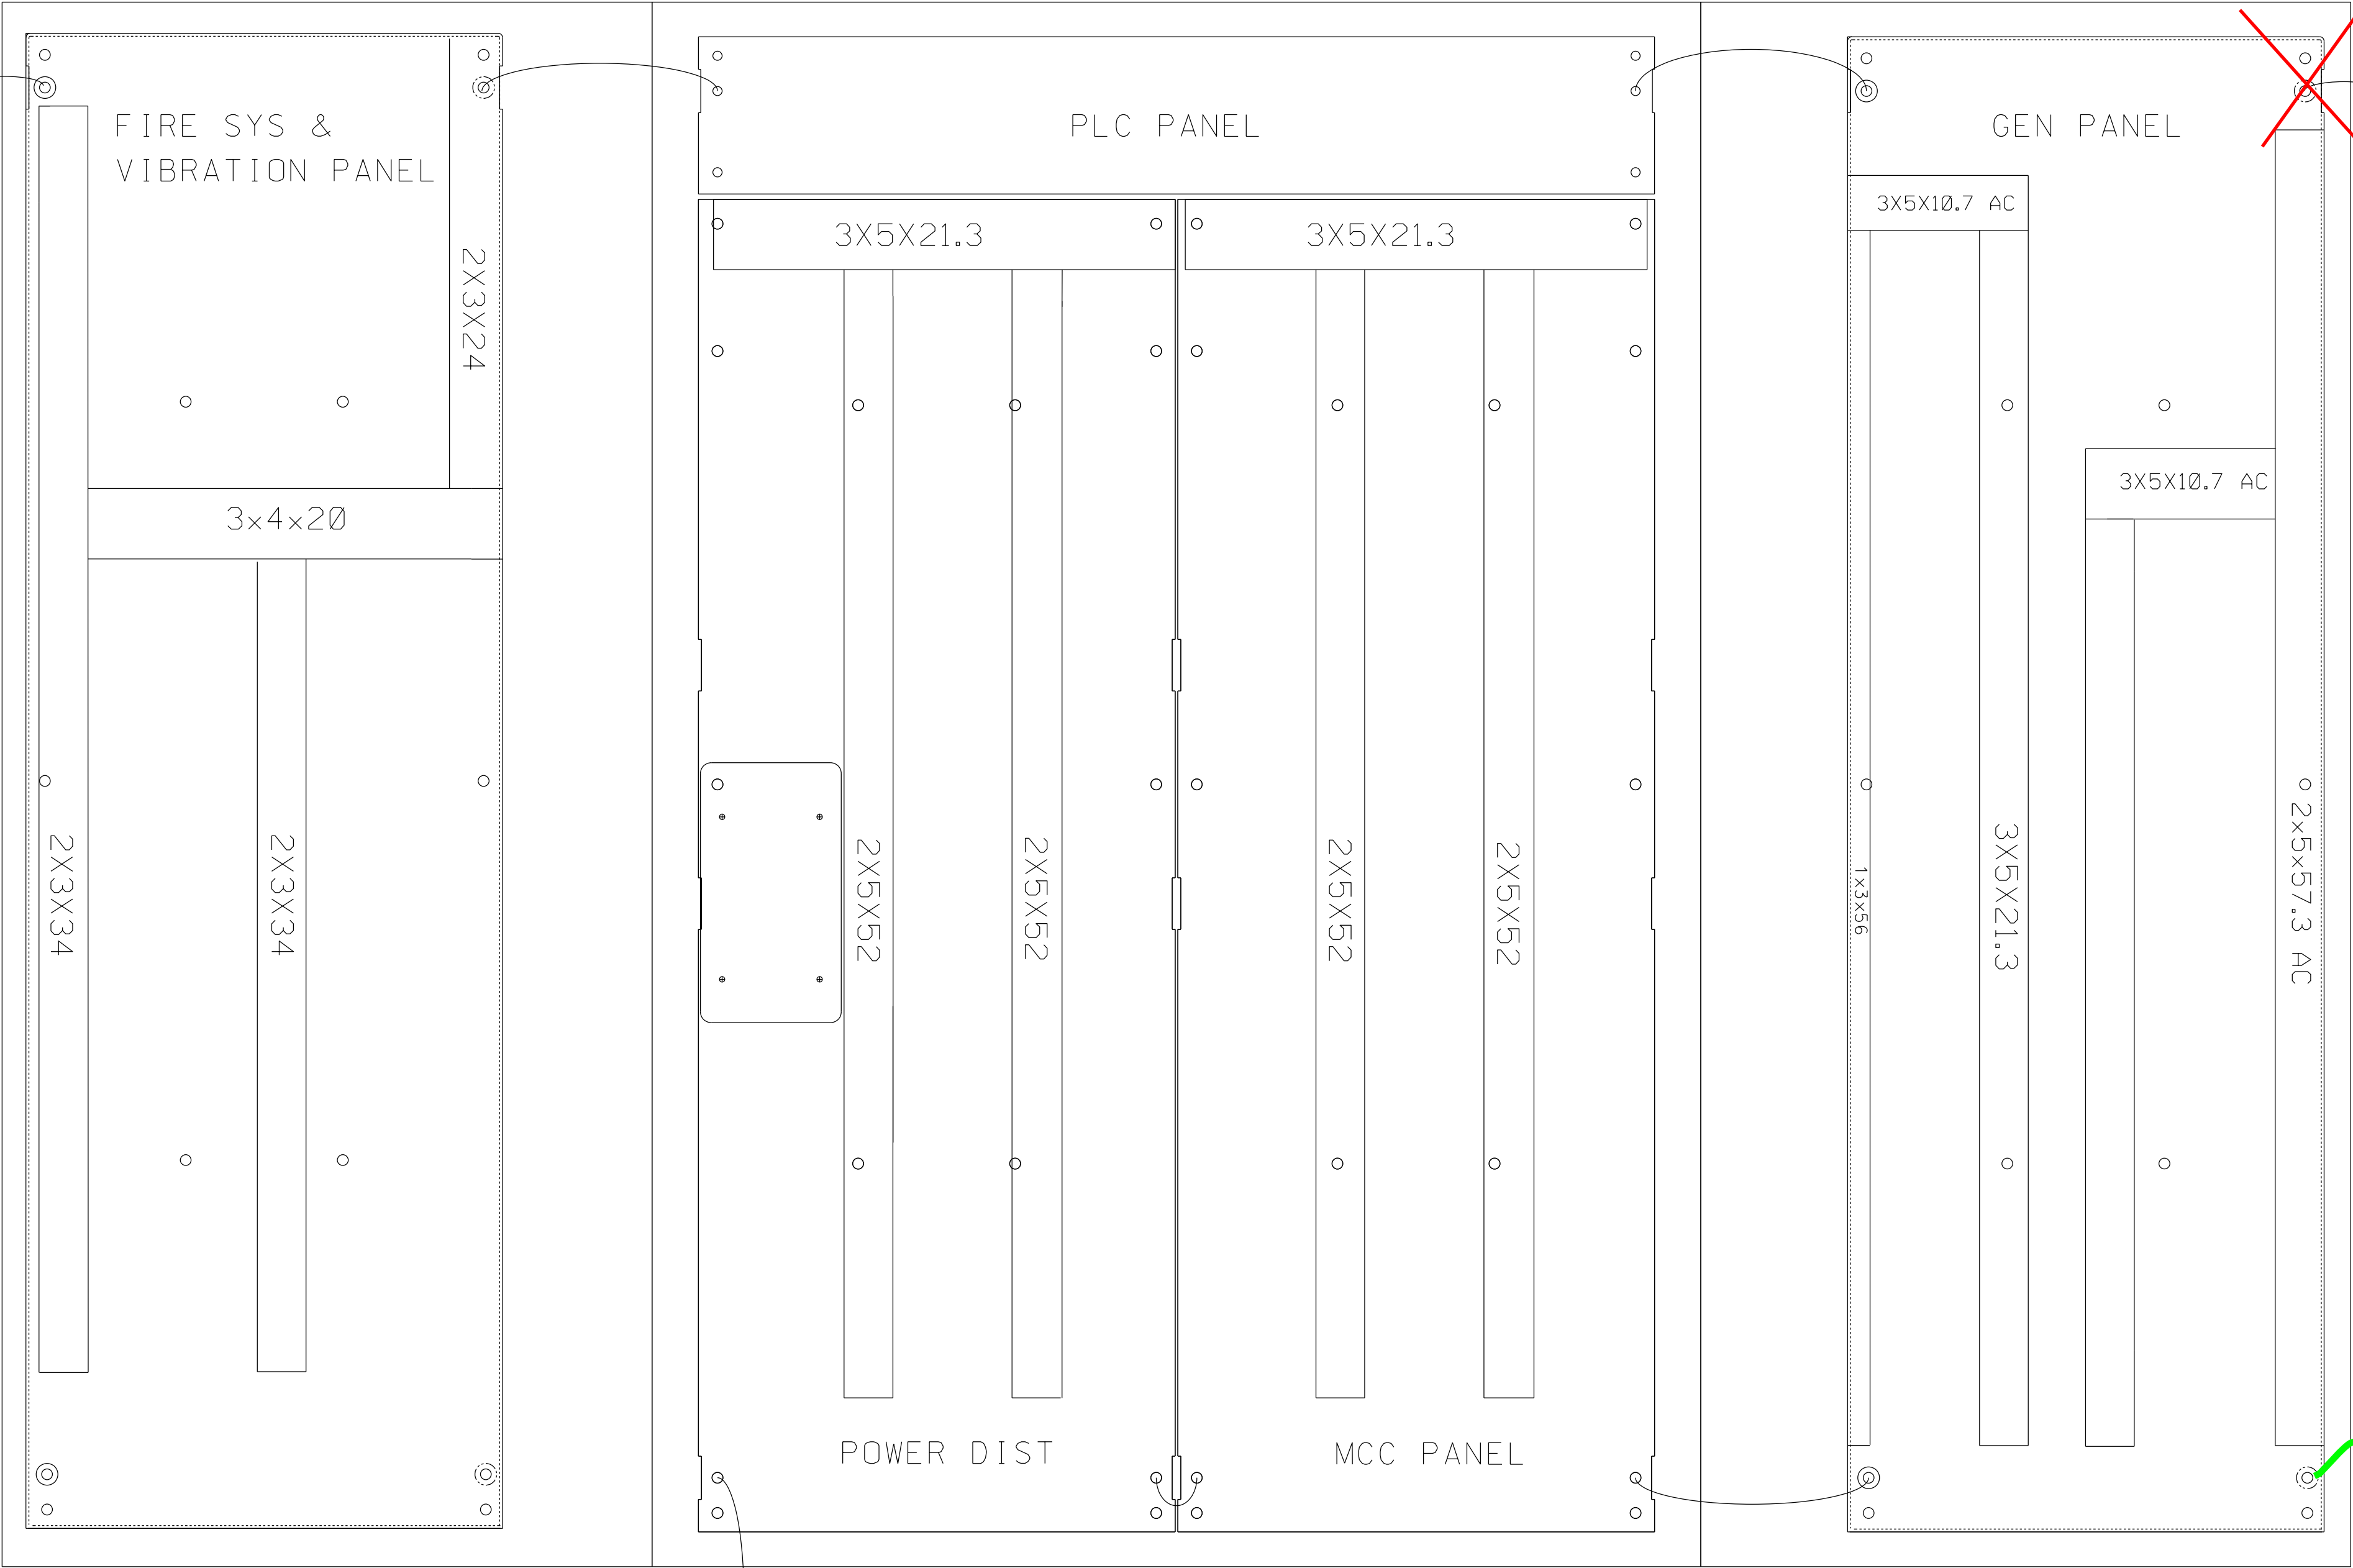

Frame ground removed to reflect As Built


Frame Ground added

BOX:1901271-4D741

CATERPILLAR CONFIDENTIAL GREEN						
THIS COPYRIGHTED WORK AND THE INFORMATION HEREIN IS PROPRIETARY TO CATERPILLAR INC., SOLAR TURBINES INCORPORATED, AND/OR SUBSIDIARIES OF EITHER. WITHOUT EXPRESS WRITTEN PERMISSION FROM CATERPILLAR INC. OR SOLAR TURBINES INCORPORATED, ANY COPYING, DISCLOSURE, OR USE EXCEPT THAT FOR WHICH IT IS LOANED, IS PROHIBITED.						
DATA CONTROL LEVEL 1	RELEASE STAMP PD- 4K391	SIZE D	CAGE NO. 66195		Solar Turbines <i>A Caterpillar Company</i> P.O. BOX 85376 San Diego, California 92186-5376	
		MFG DES ENGINEER	DATE	DRAWING TITLE CONTROL,2-BAY		
		10/31/2025				
		DESIGN ENGINEER	DATE			
		10/31/2025				
PROJECT NAME Enterprise SMT130 M4 WTX				PANEL NO.0		
MODEL	CTLM02 TURBOTRONICS 4			DWG NO.	4K391-2876518	SHT REV 0.0
LOC	T:\PROJECT\LAYOUT\REV\			DWG REV 0.2	SHEET 5 OF 14	


7		8	
THIS PRINT IS PROVIDED ON A RESTRICTED BASIS AND IS NOT TO BE USED IN ANY WAY DETRIMENTAL TO SOLAR TURBINES INCORPORATED.			
REVISION HISTORY			
REV	DESCRIPTION	DATE	APPROVED
0	0	0	0
0.2		10/31/25	

KA0460

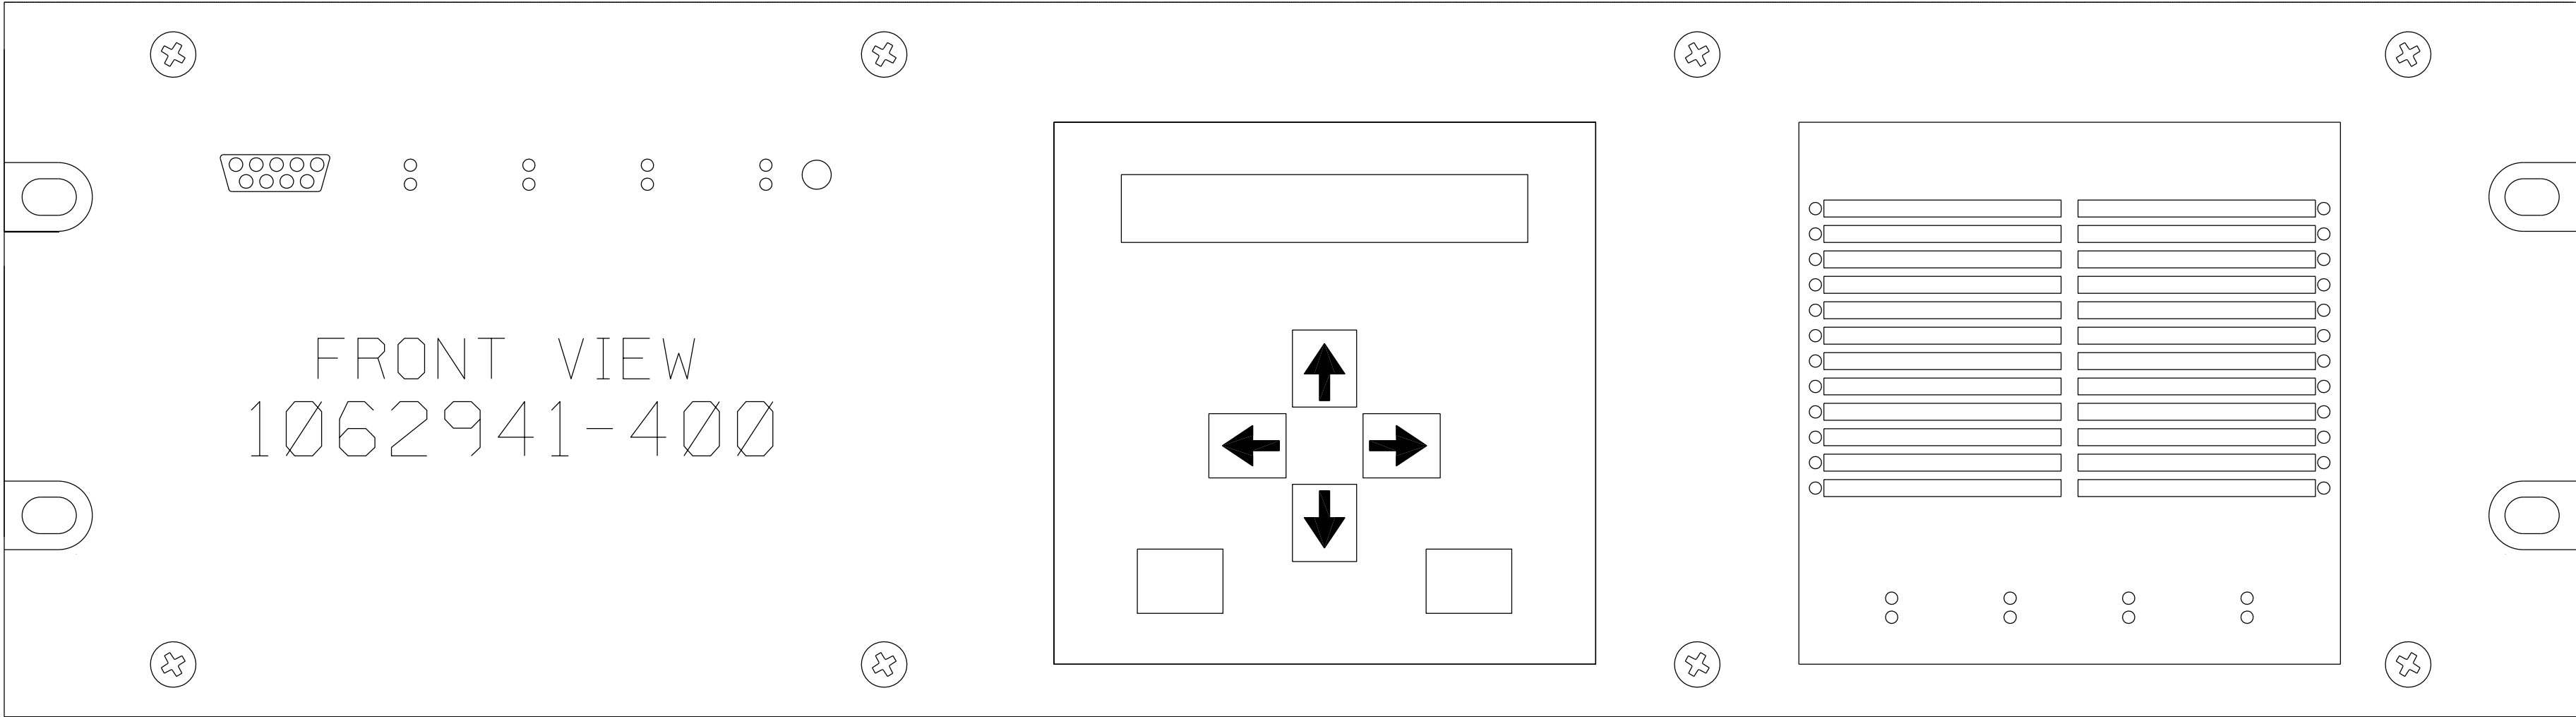


CATERPILLAR CONFIDENTIAL GREEN						
THIS COPYRIGHTED WORK AND THE INFORMATION HEREIN IS PROPRIETARY TO CATERPILLAR INC., SOLAR TURBINES INCORPORATED, AND/OR SUBSIDIARIES OF EITHER. WITHOUT EXPRESS WRITTEN PERMISSION FROM CATERPILLAR INC. OR SOLAR TURBINES INCORPORATED, ANY COPYING, DISCLOSURE, OR USE EXCEPT THAT FOR WHICH IT IS LOANED, IS PROHIBITED.						
DATA CONTROL LEVEL 1	RELEASE STAMP PD- 4K391	SIZE D	CAGE NO. 66195	Solar Turbines <i>A Caterpillar Company</i>		P.O. BOX 85376 San Diego, California 92186-5376
		MFG DES ENGINEER	DATE 10/31/2025	DRAWING TITLE BECKWITH RELAY,SMT130		
		DESIGN ENGINEER	DATE 10/31/2025			
		PROJECT NAME Enterprise SMT130 M4 WTX			PANEL NO.0	
MODEL	CTLMO2 TURBOTRONICS 4			DWG NO.	4K391-2864766	SHT REV 0.0
LOC	T:\PROJECT\LAYOUT\REV\			DWG REV 0.2	SHEET 6 OF 14	



7		8	
THIS PRINT IS PROVIDED ON A RESTRICTED BASIS AND IS NOT TO BE USED IN ANY WAY DETRIMENTAL TO SOLAR TURBINES INCORPORATED.			
REVISION HISTORY			
REV	DESCRIPTION	DATE	APPROVED
0	0	0	0
0.2		10/31/25	

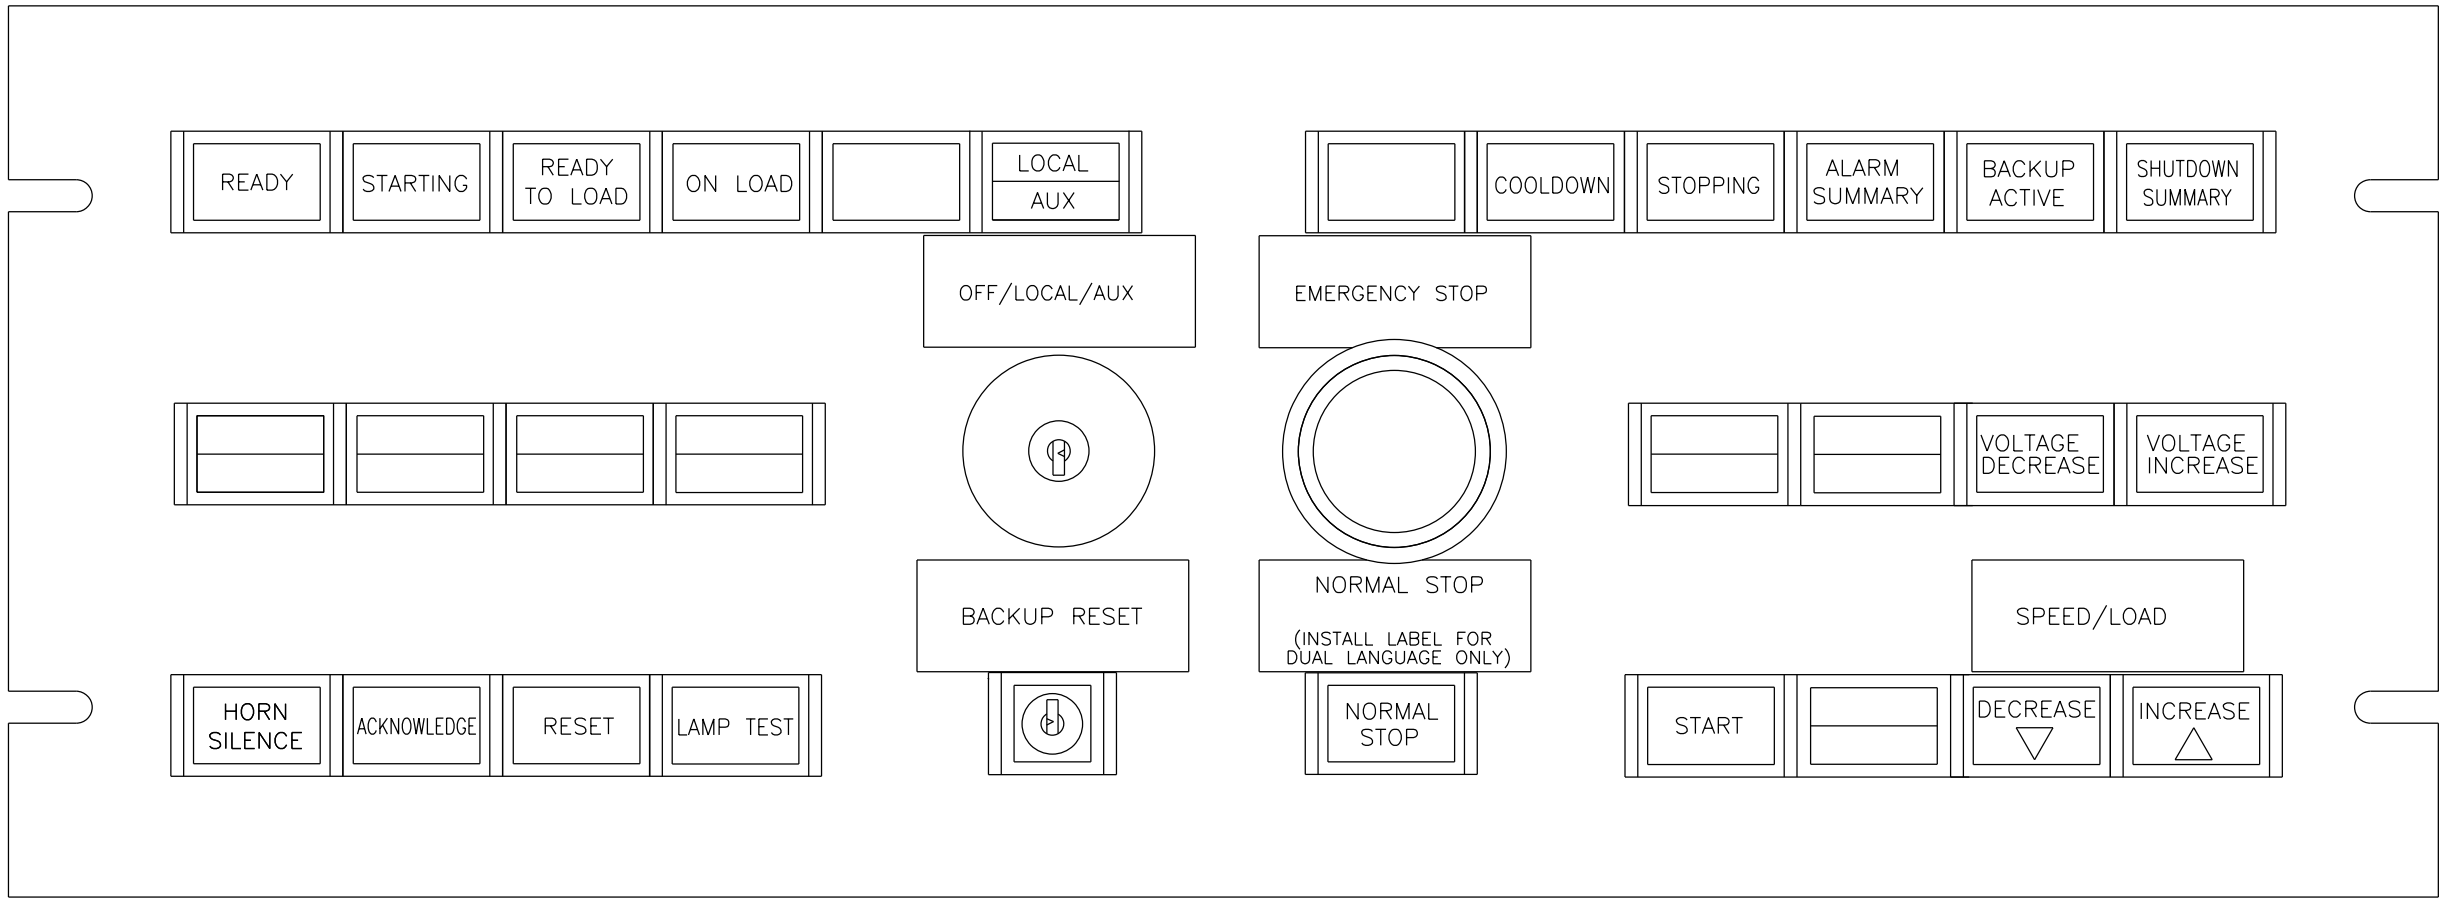

FRONT VIEW

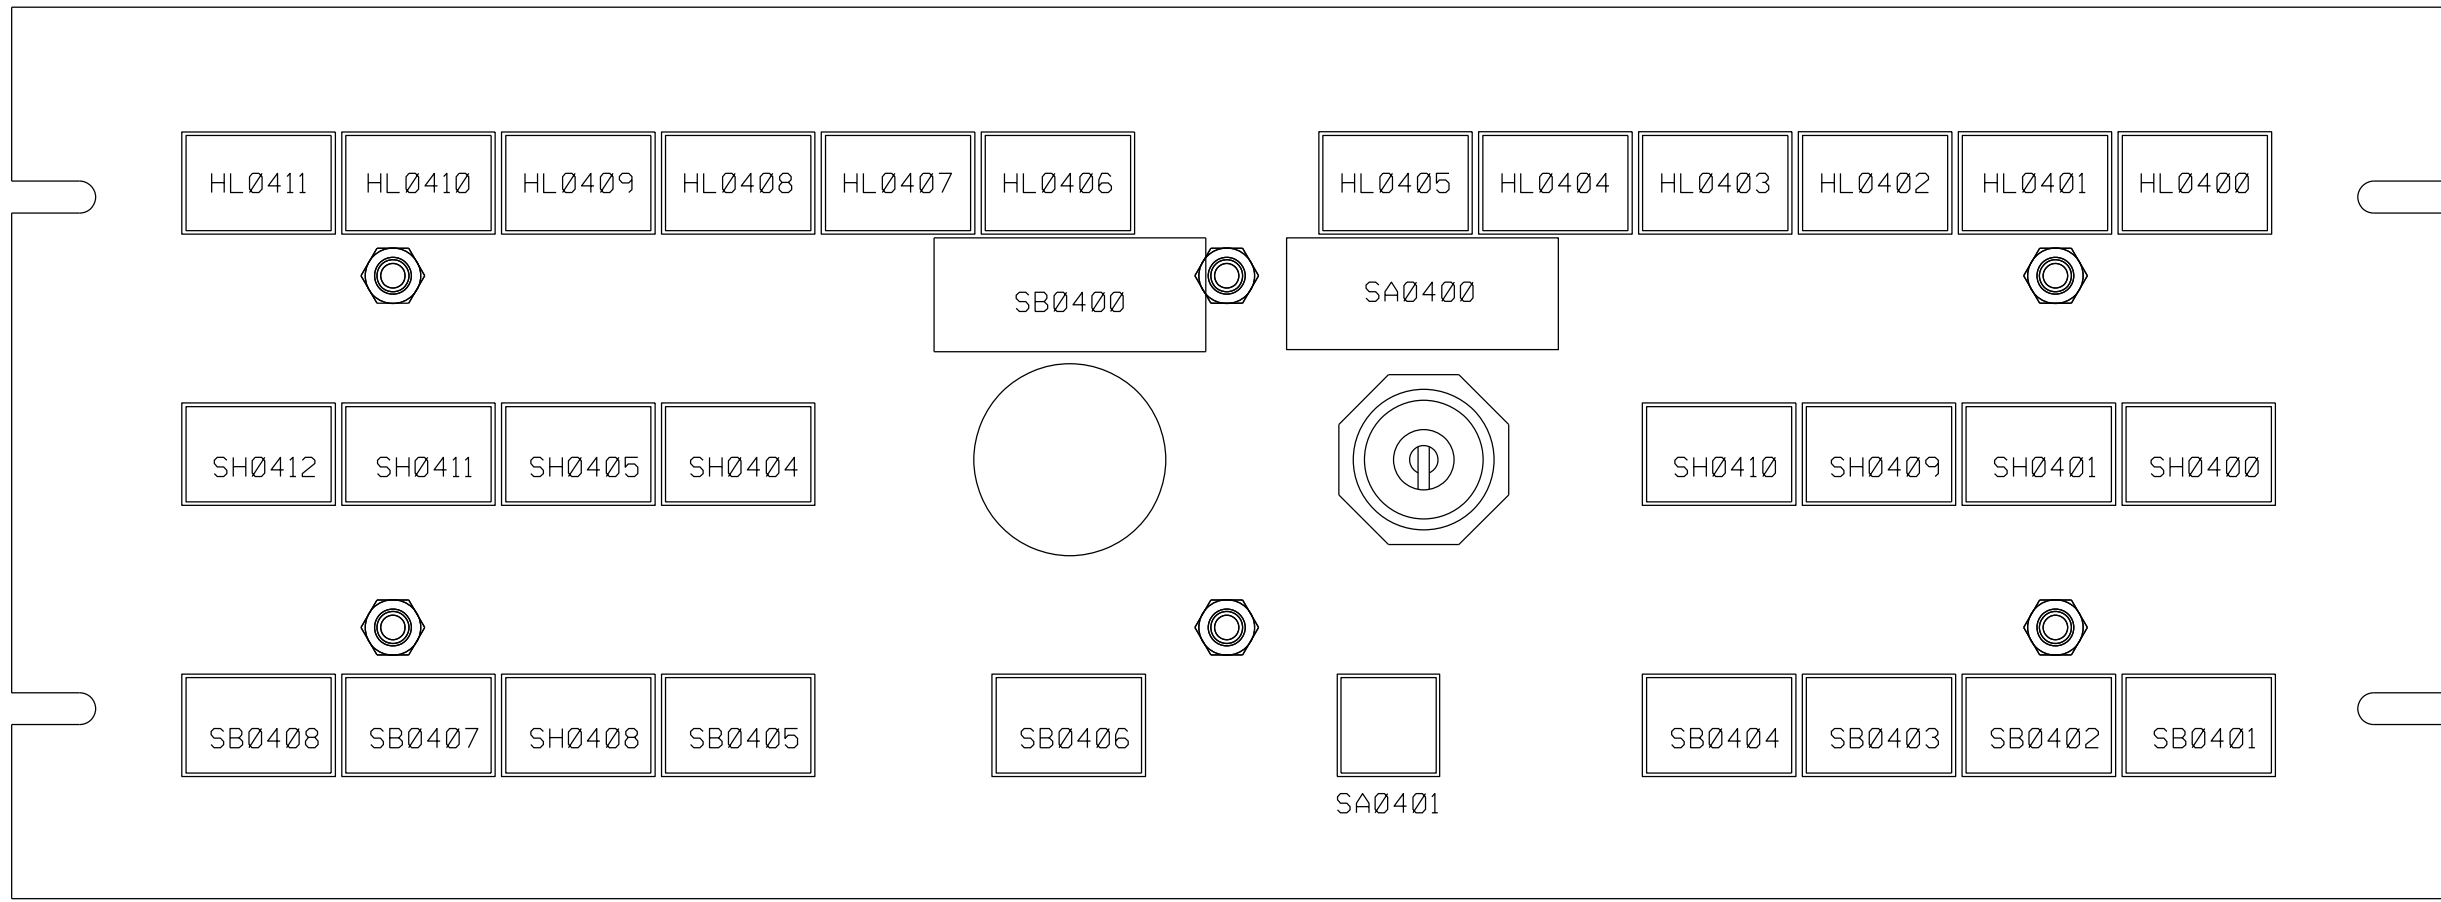

BACK VIEW
WITH FLEX I/O REMOVED

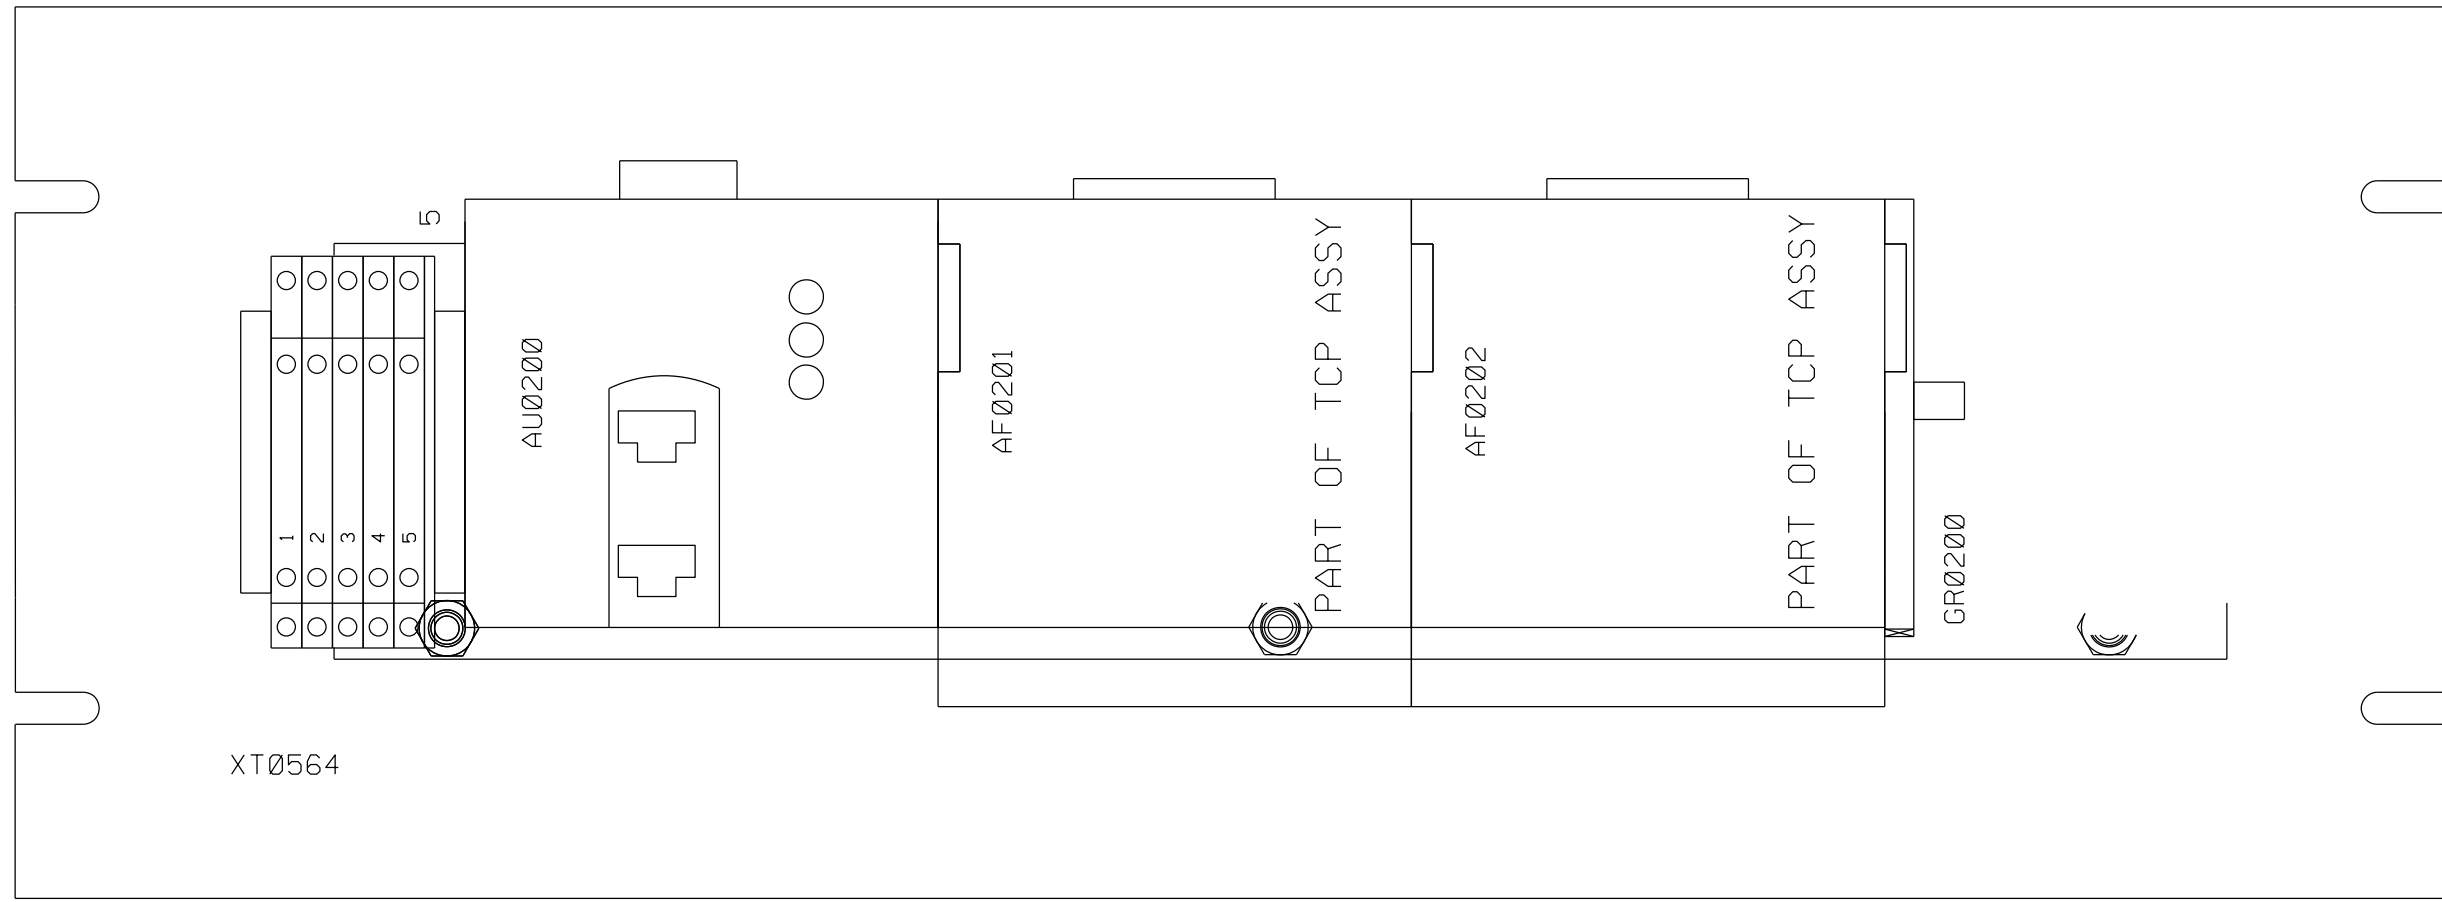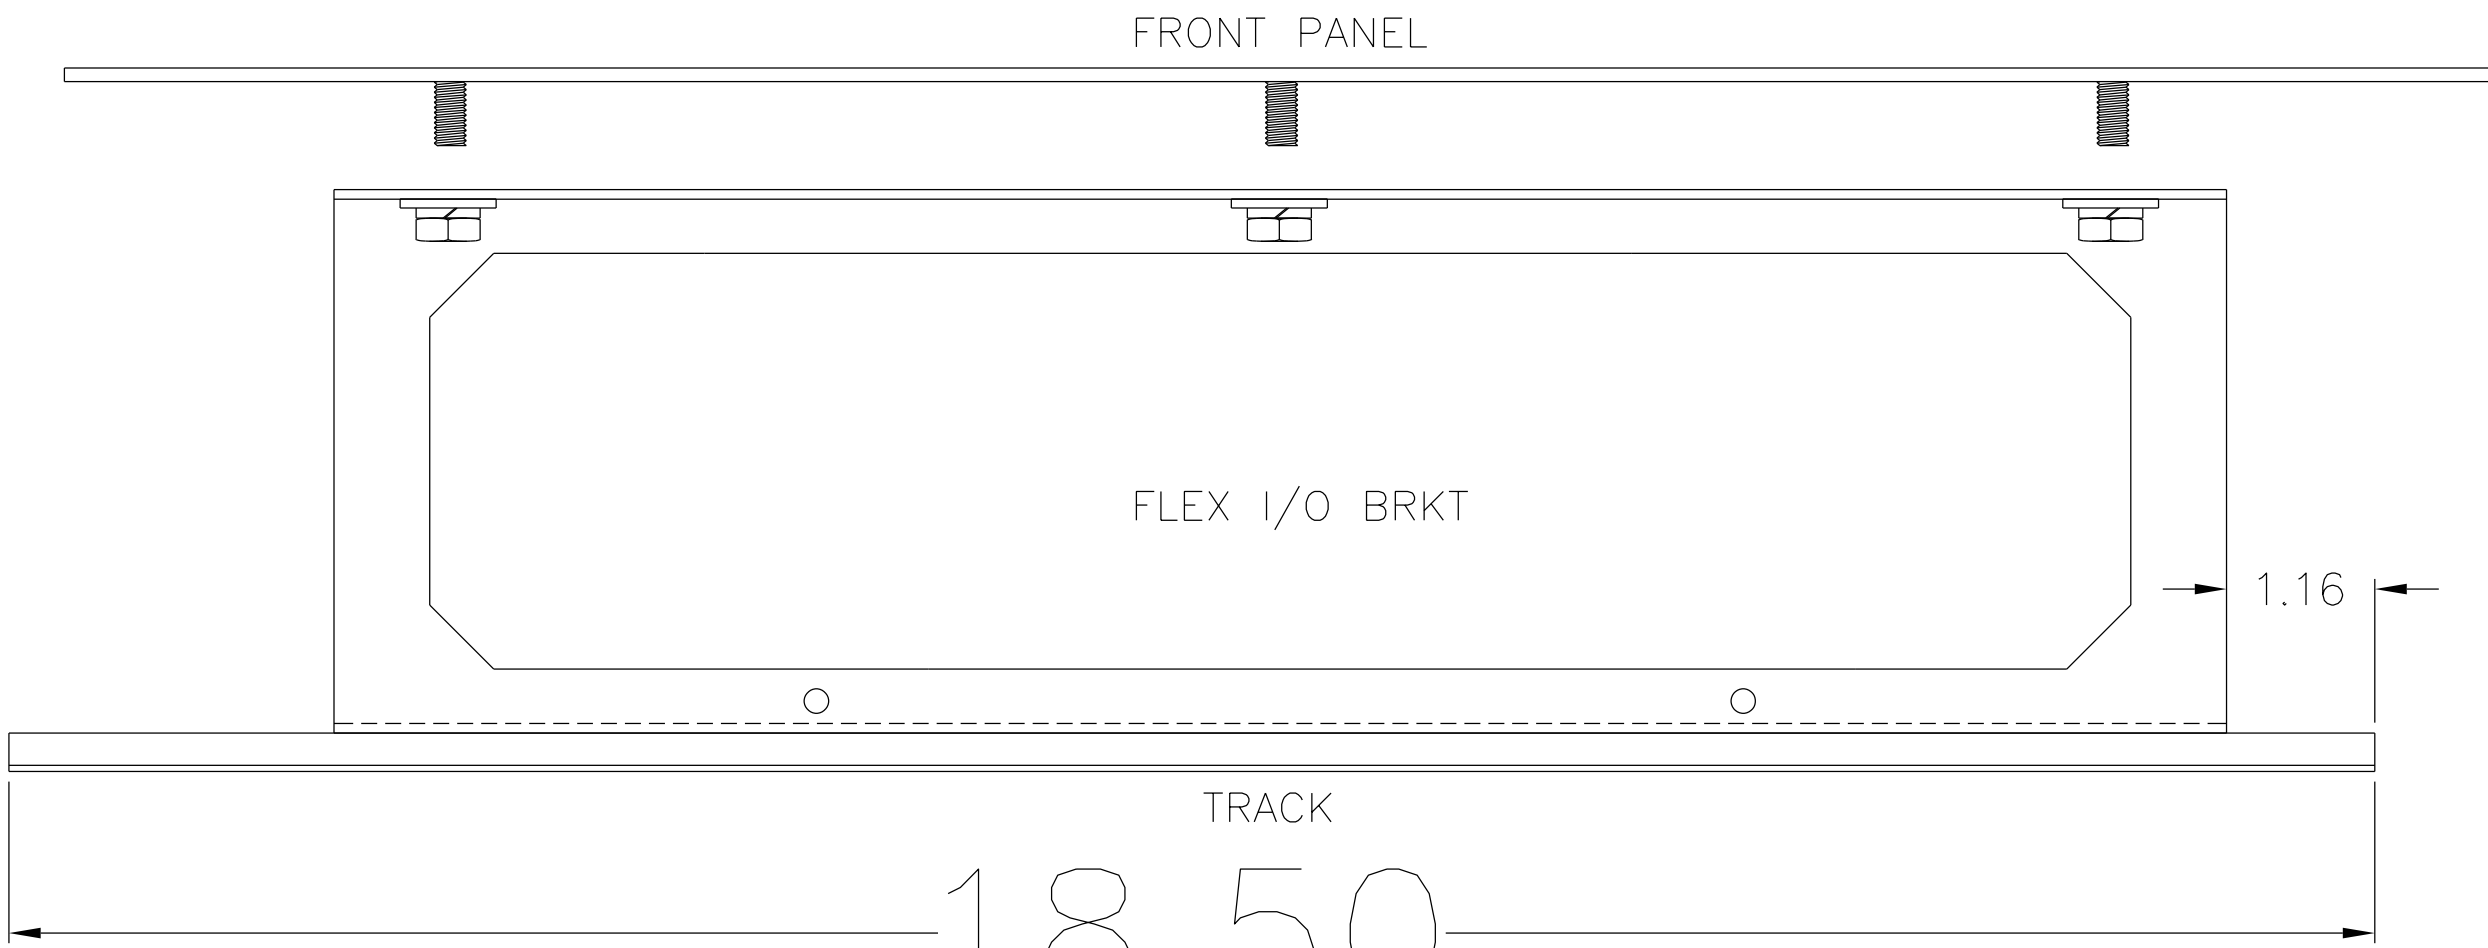


TYP. FOR XT0564
BACK VIEW
WITH FLEX I/O INSTALLED

PN: 1507708-501

CATERPILLAR CONFIDENTIAL GREEN						
THIS COPYRIGHTED WORK AND THE INFORMATION HEREIN IS PROPRIETARY TO CATERPILLAR INC., SOLAR TURBINES INCORPORATED, AND/OR SUBSIDIARIES OF EITHER. WITHOUT EXPRESS WRITTEN PERMISSION FROM CATERPILLAR INC. OR SOLAR TURBINES INCORPORATED, ANY COPYING, DISCLOSURE, OR USE EXCEPT THAT FOR WHICH IT IS LOANED, IS PROHIBITED.						
DATA CONTROL LEVEL 1	RELEASE STAMP PD- 4K391	SIZE	CAGE NO.		Solar[®]Turbines <i>A Caterpillar Company</i> P.O. BOX 85376 San Diego, California 92186-5376	
		D	66195			
		MFG DES ENGINEER	DATE	DRAWING TITLE TCP, SMT130		
			10/31/2025			
		DESIGN ENGINEER	DATE			
			10/31/2025			
PROJECT NAME					PANEL NO.0	
Enterprise SMT130 M4 WTX						
MODEL	CTLMO2 TURBOTRONICS 4				DWG NO. 4K391-2897170	SHT REV 0.0
LOC	T:\PROJECT\LAYOUT\REV\				DWG REV 0.2	SHEET 7 OF 14

7		8	
THIS PRINT IS PROVIDED ON A RESTRICTED BASIS AND IS NOT TO BE USED IN ANY WAY DETRIMENTAL TO SOLAR TURBINES INCORPORATED.			
REVISION HISTORY			
REV	DESCRIPTION	DATE	APPROVED
0	0	0	0
0.2		10/31/25	


MOUNTED ABOVE THE TCP

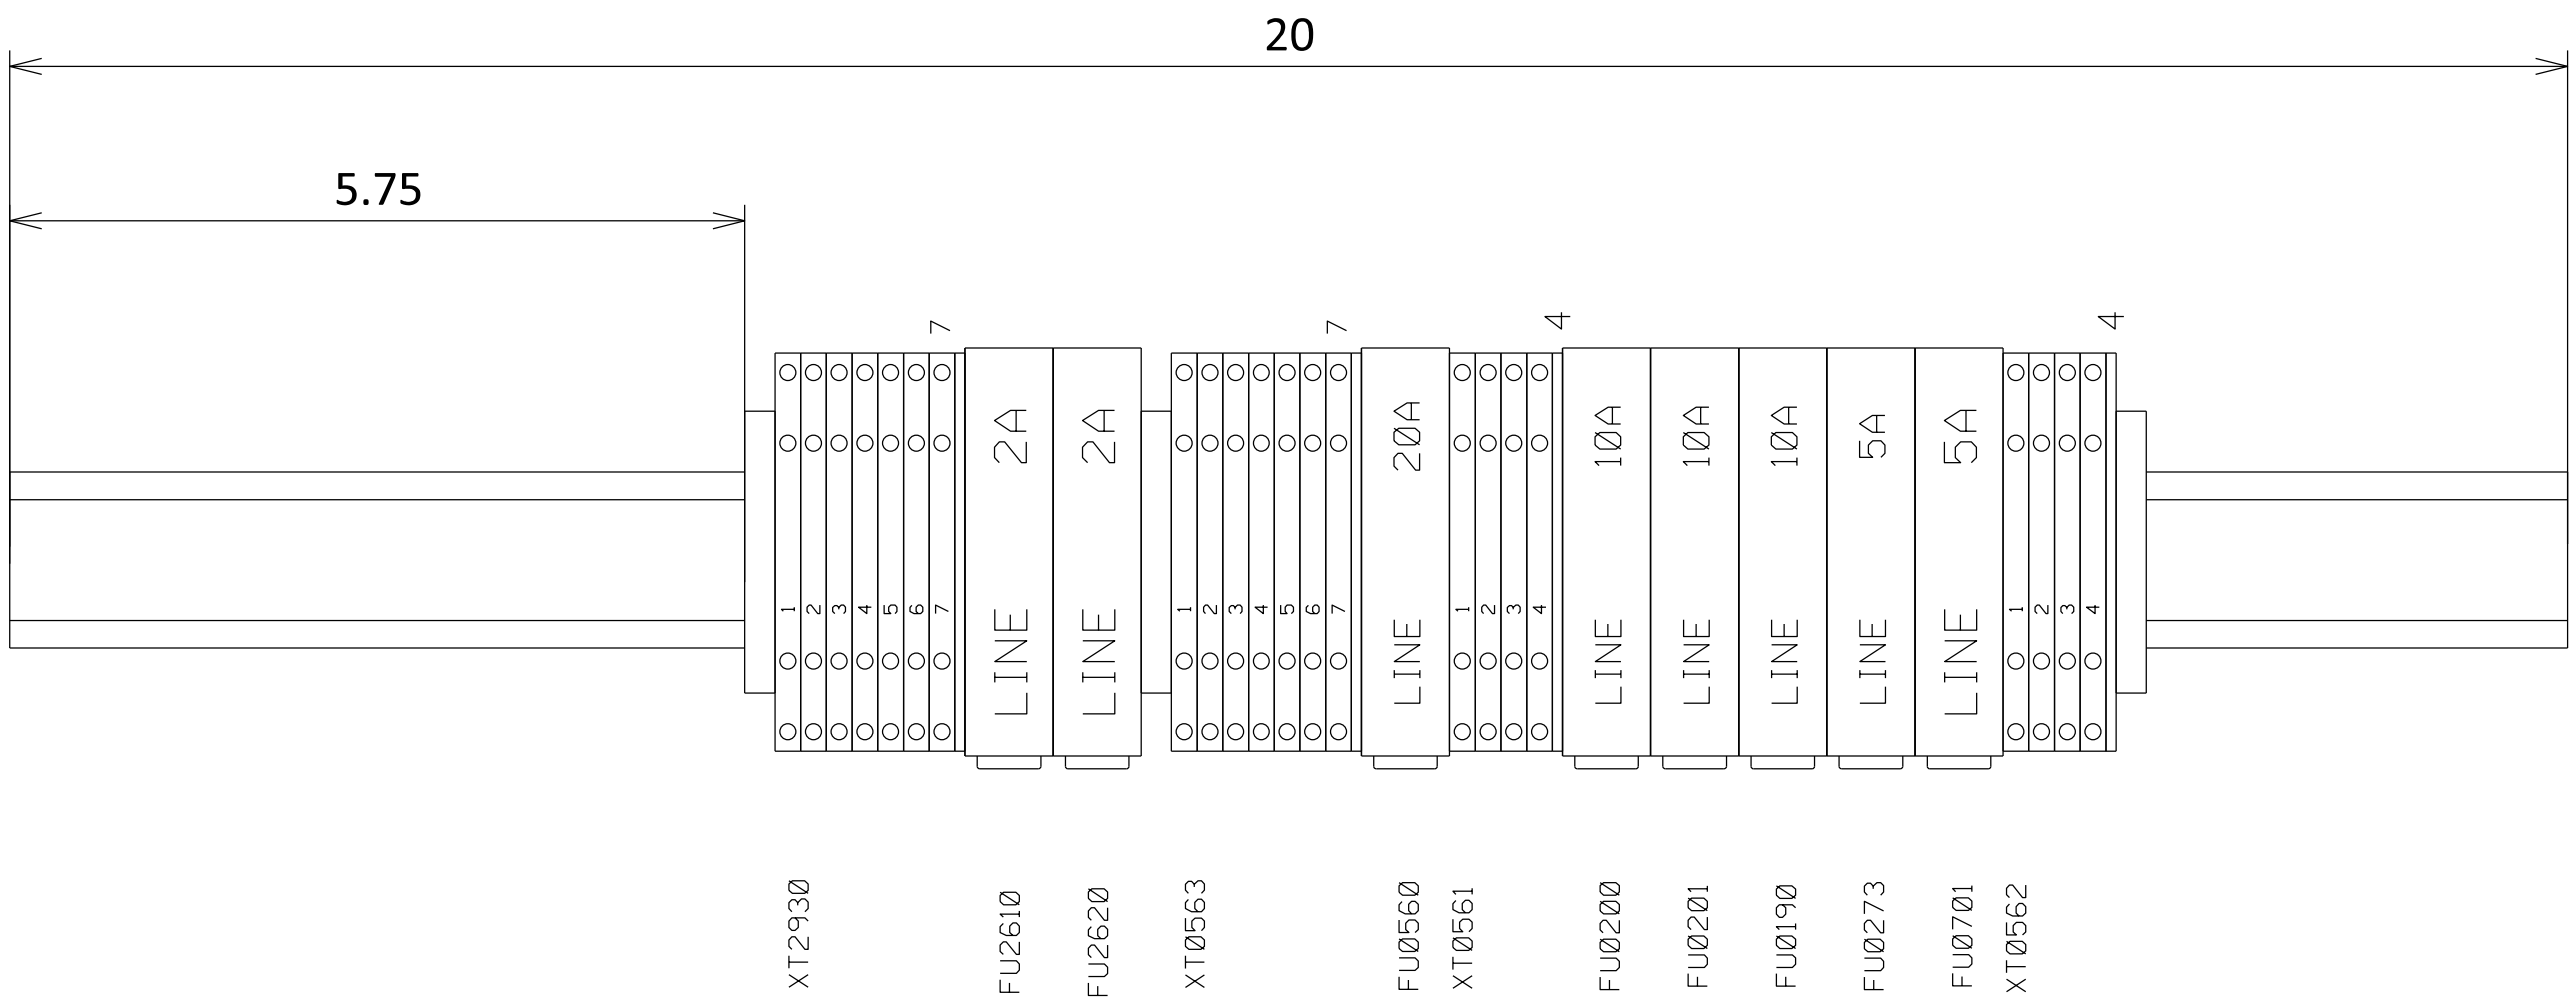

CATERPILLAR CONFIDENTIAL GREEN						
THIS COPYRIGHTED WORK AND THE INFORMATION HEREIN IS PROPRIETARY TO CATERPILLAR INC., SOLAR TURBINES INCORPORATED, AND/OR SUBSIDIARIES OF EITHER. WITHOUT EXPRESS WRITTEN PERMISSION FROM CATERPILLAR INC. OR SOLAR TURBINES INCORPORATED, ANY COPYING, DISCLOSURE, OR USE EXCEPT THAT FOR WHICH IT IS LOANED, IS PROHIBITED.						
DATA CONTROL LEVEL 1	RELEASE STAMP PD- 4K391	SIZE	CAGE NO.		Solar Turbines <i>A Caterpillar Company</i>	P.O. BOX 85376 San Diego, California 92186-5376
		D	66195			
		MFG DES ENGINEER	DATE	DRAWING TITLE		
		DESIGN ENGINEER	DATE			
			10/31/2025	PWR DST,DR,SMT130		
			10/31/2025			
PROJECT NAME					PANEL NO.0	
Enterprise SMT130 M4 WTX						
MODEL	CTLM02 TURBOTRONICS 4				DWG NO.	4K391-2897176
LOC	T:\PROJECT\LAYOUT\REV\				SHT	0.0
					DWG REV	0.2
					SHEET	8 OF 14

SPRING

7		8	
THIS PRINT IS PROVIDED ON A RESTRICTED BASIS AND IS NOT TO BE USED IN ANY WAY DETRIMENTAL TO SOLAR TURBINES INCORPORATED.			
REVISION HISTORY			
REV	DESCRIPTION	DATE	APPROVED
0	0	0	0
0.2		10/31/25	

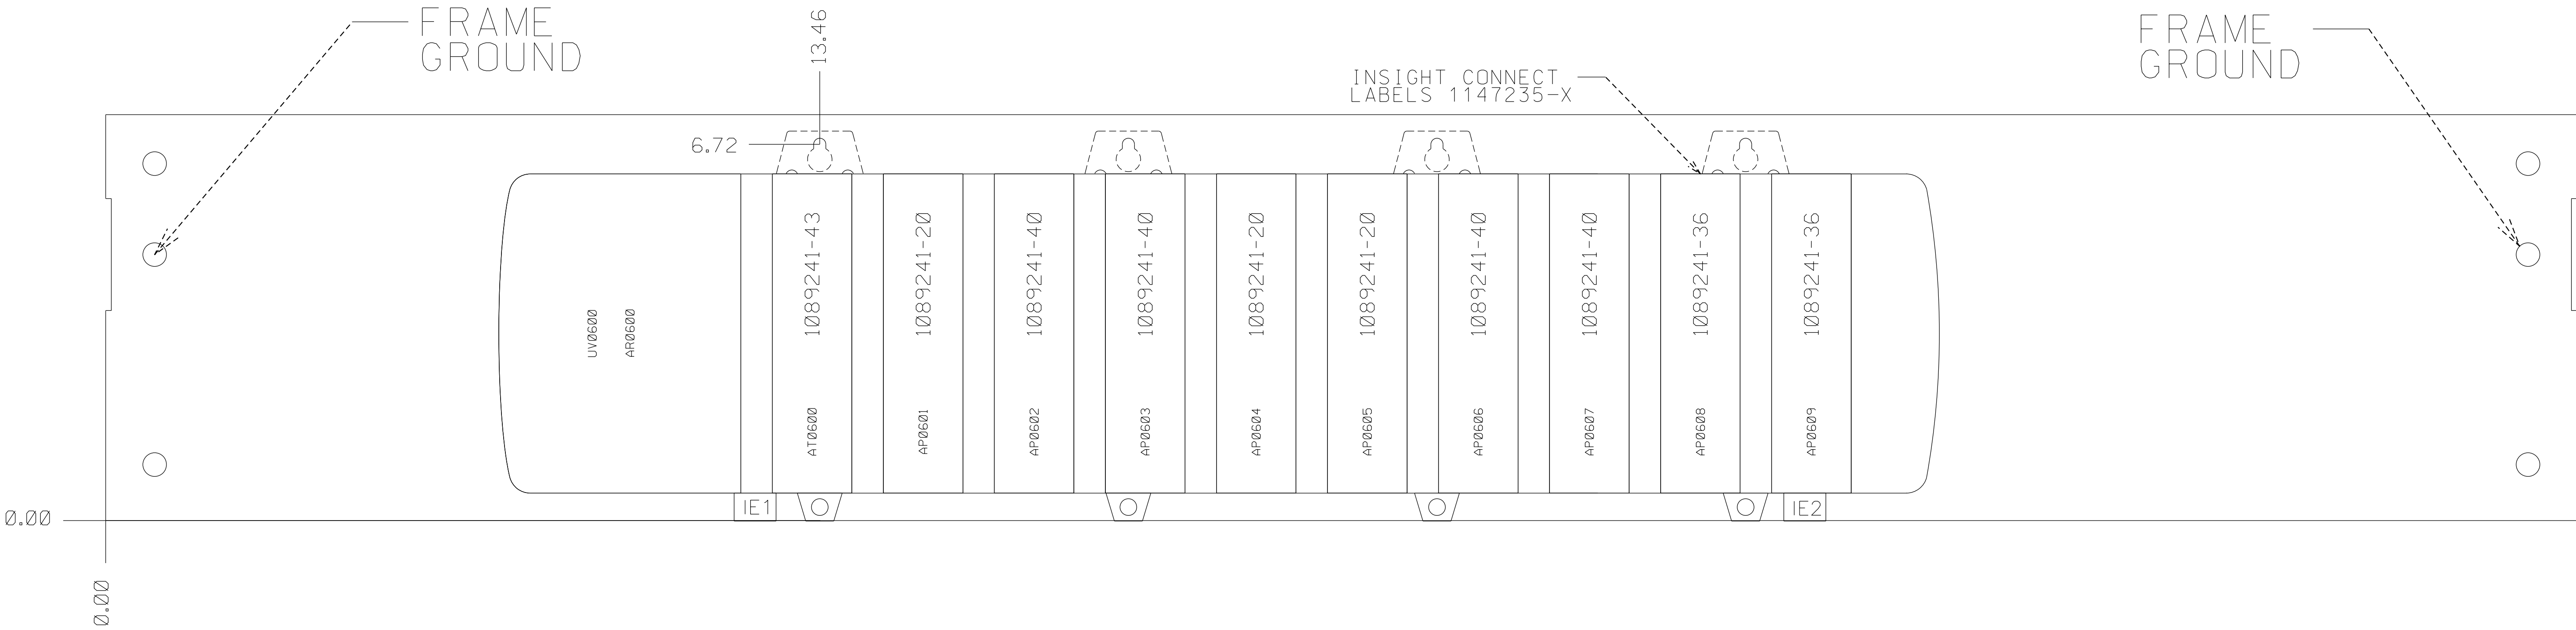

BOX: 1901271-4D741
PANEL: 1058112-2001

CATERPILLAR CONFIDENTIAL GREEN							
THIS COPYRIGHTED WORK AND THE INFORMATION HEREIN IS PROPRIETARY TO CATERPILLAR INC., SOLAR TURBINES INCORPORATED, AND/OR SUBSIDIARIES OF EITHER. WITHOUT EXPRESS WRITTEN PERMISSION FROM CATERPILLAR INC. OR SOLAR TURBINES INCORPORATED, ANY COPYING, DISCLOSURE, OR USE EXCEPT THAT FOR WHICH IT IS LOANED, IS PROHIBITED.							
DATA CONTROL LEVEL 1	RELEASE STAMP PD- 4K391	SIZE D	CAGE NO. 66195		Solar Turbines <i>A Caterpillar Company</i>	P.O. BOX 85376 San Diego, California 92186-5376	
		MFG DES ENGINEER	DATE 10/31/2025	DRAWING TITLE PLC, PANEL			
		DESIGN ENGINEER	DATE 10/31/2025				
			PROJECT NAME Enterprise SMT130 M4 WTX				PANEL NO. 0
MODEL	CTLMO2 TURBOTRONICS 4				DWG NO.	4K391-2876513	SHT REV 0.0
LOC	T:\PROJECT\LAYOUT\REV\				DWG REV 0.2		SHEET 9 OF 14

THIS PRINT IS PROVIDED ON A RESTRICTED BASIS AND IS NOT TO BE USED IN ANY WAY DETRIMENTAL TO SOLAR TURBINES INCORPORATED.			
REVISION HISTORY			
REV	DESCRIPTION	DATE	APPROVED
0	0	0	0
0.2		10/31/25	




FRAME
GROUND

2X3X21

3x4x19

2X3X38

2X3X53

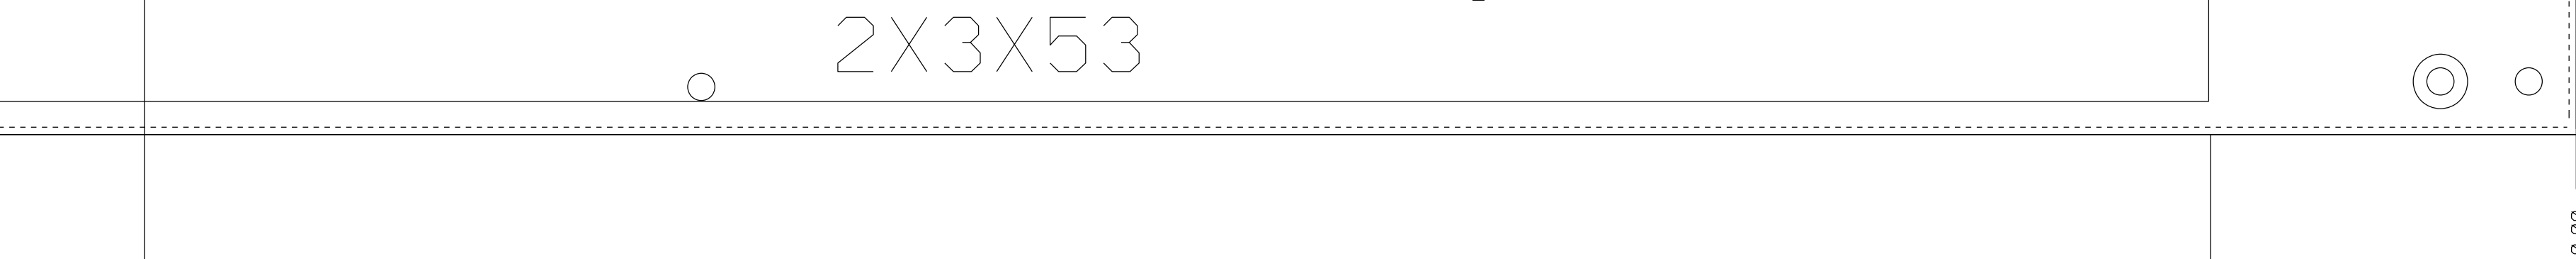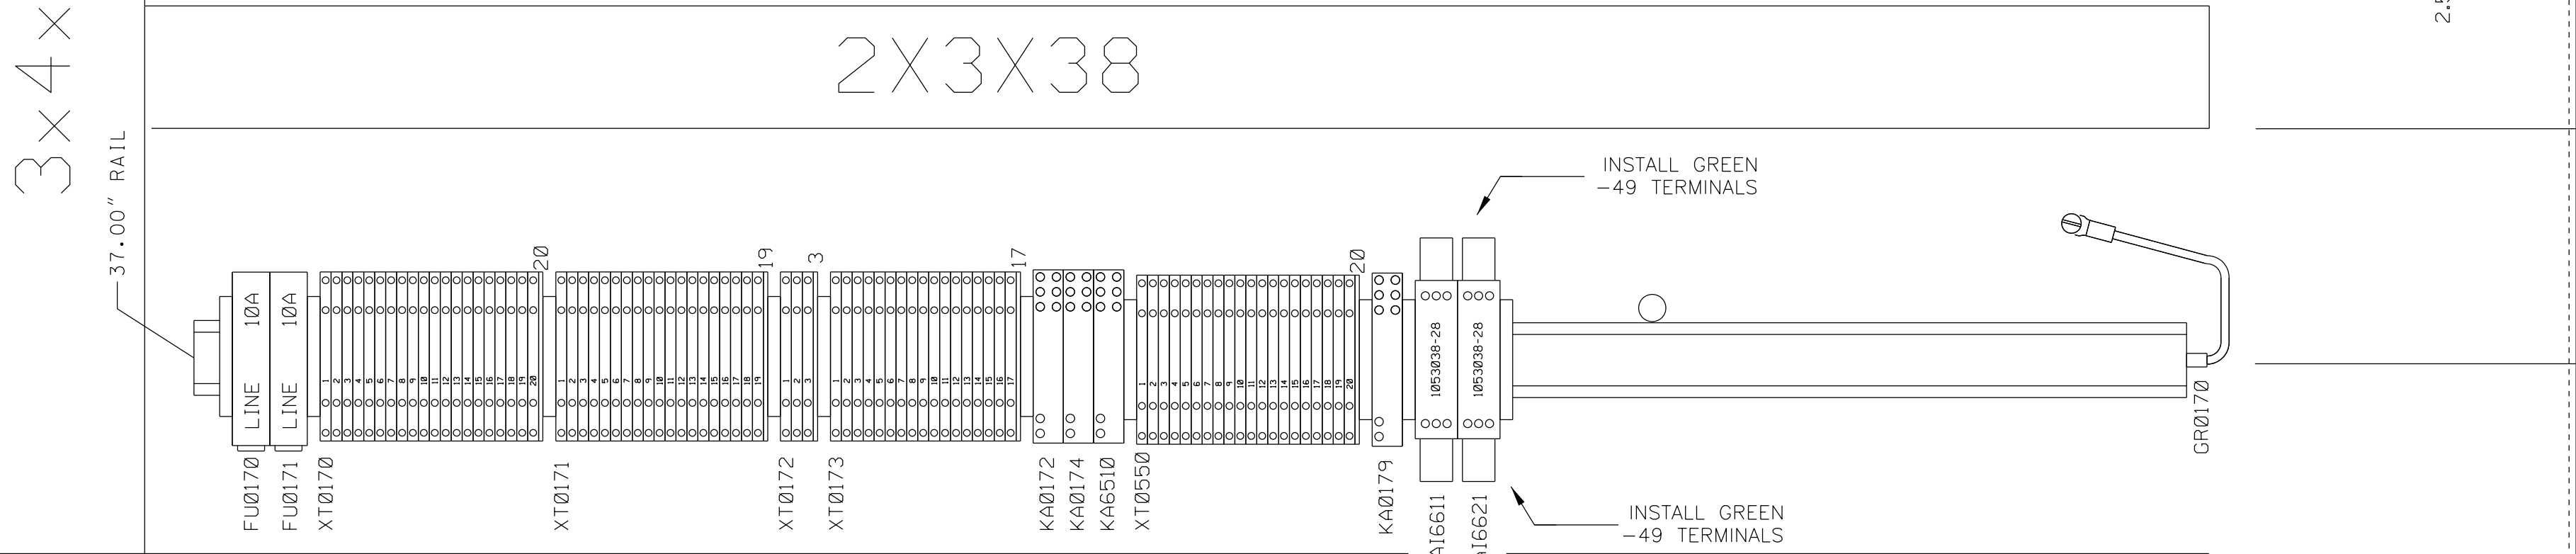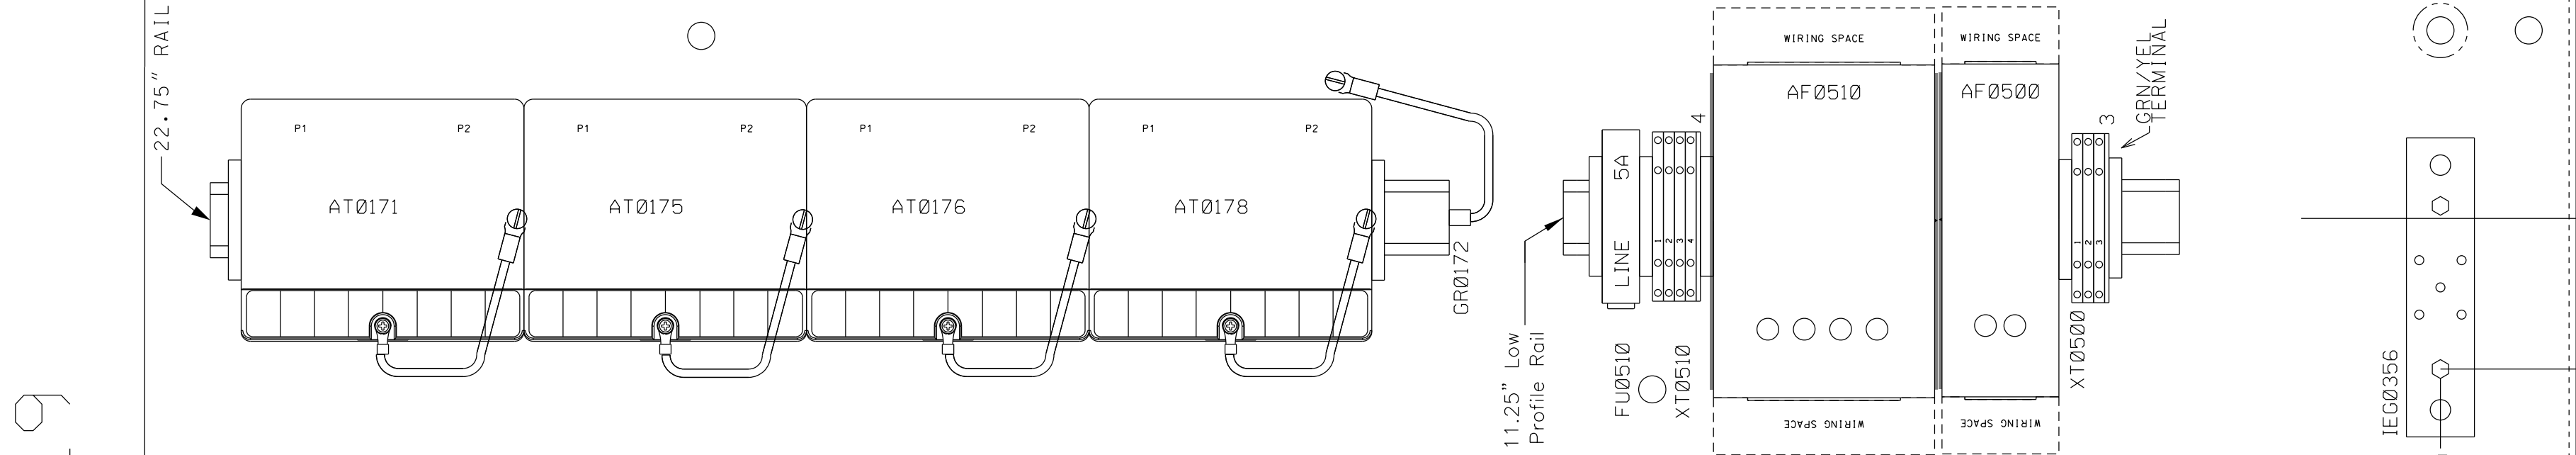


FRAME
GROUND

BOX : 1901271-4D741
PANEL : 1053331-501

CATERPILLAR CONFIDENTIAL GREEN						
THIS COPYRIGHTED WORK AND THE INFORMATION HEREIN IS PROPRIETARY TO CATERPILLAR INC., SOLAR TURBINES INCORPORATED, AND/OR SUBSIDIARIES OF EITHER. WITHOUT EXPRESS WRITTEN PERMISSION FROM CATERPILLAR INC. OR SOLAR TURBINES INCORPORATED, ANY COPYING, DISCLOSURE, OR USE EXCEPT THAT FOR WHICH IT IS LOANED, IS PROHIBITED.						
DATA CONTROL LEVEL 1	RELEASE STAMP PD- 4K391	SIZE D	CAGE NO. 66195		Solar Turbines <i>A Caterpillar Company</i> P.O. BOX 85376 San Diego, California 92186-5376	
		MFG DES ENGINEER	DATE	DRAWING TITLE FG&E CTRL,SMT130		
		DESIGN ENGINEER	10/31/2025			
			DATE			10/31/2025
PROJECT NAME Enterprise SMT130 M4 WTX					PANEL NO. 0	
MODEL	CTLMO2 TURBOTRONICS 4				DWG NO. 4K391-2870169	SHT REV 0.0
LOC	T:\PROJECT\LAYOUT\REV\				DWG REV 0.2	SHEET 10 OF 14

THIS PRINT IS PROVIDED ON A RESTRICTED BASIS AND IS NOT TO BE USED IN ANY WAY DETRIMENTAL TO SOLAR TURBINES INCORPORATED.			
REVISION HISTORY			
REV	DESCRIPTION	DATE	APPROVED
0	0	0	0
0.2		10/31/25	

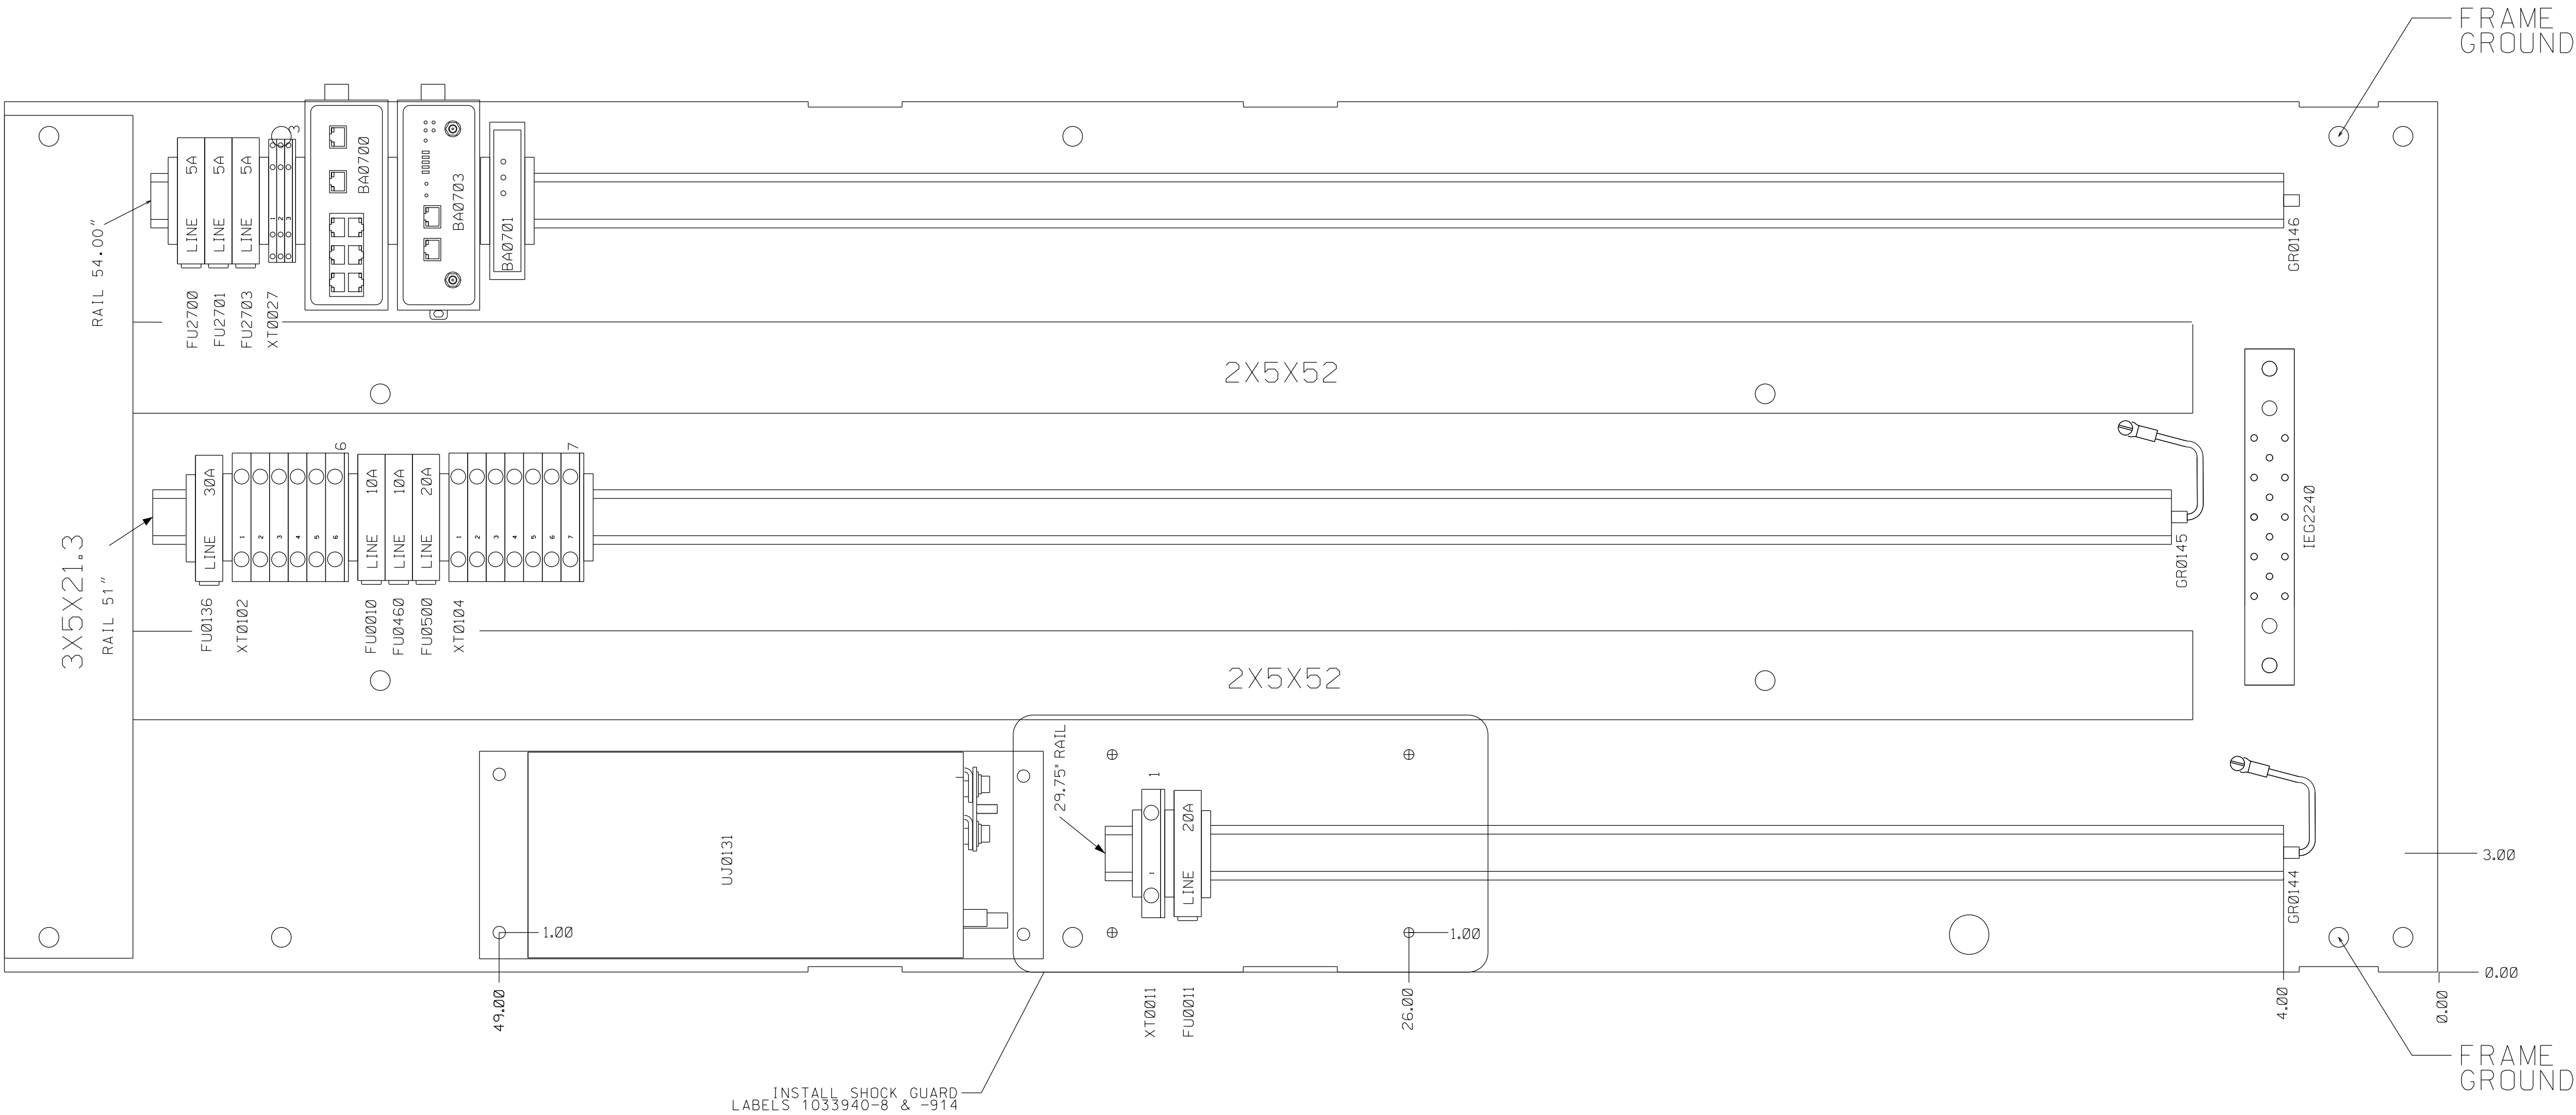


INSTALL SHOCK GUARD
LABELS 1033940-8 & -914

BOX : 1901271-4D741
PANEL : 1058112-2202

CATERPILLAR CONFIDENTIAL GREEN						
THIS COPYRIGHTED WORK AND THE INFORMATION HEREIN IS PROPRIETARY TO CATERPILLAR INC., SOLAR TURBINES INCORPORATED, AND/OR SUBSIDIARIES OF EITHER. WITHOUT EXPRESS WRITTEN PERMISSION FROM CATERPILLAR INC. OR SOLAR TURBINES INCORPORATED, ANY COPYING, DISCLOSURE, OR USE EXCEPT THAT FOR WHICH IT IS LOANED, IS PROHIBITED."						
DATA CONTROL LEVEL 1	RELEASE STAMP PD- 4K391	SIZE D	CAGE NO. 66195		Solar Turbines <i>A Caterpillar Company</i> P.O. BOX 85376 San Diego, California 92186-5376	
		MFG DES ENGINEER	DATE	DRAWING TITLE POWERDIST, PANEL		
		DESIGN ENGINEER	10/31/2025			
			DATE			10/31/2025
PROJECT NAME Enterprise SMT130 M4 WTX				PANEL NO. 0		
MODEL	CTLMO2 TURBOTRONICS 4			DWG NO.	4K391-2876489	SHT REV 0.0
LOC	T:\PROJECT\LAYOUT\REV\			DWG REV 0.2		SHEET 11 OF 14

THIS PRINT IS PROVIDED ON A RESTRICTED BASIS AND IS NOT TO BE USED IN ANY WAY DETRIMENTAL TO SOLAR TURBINES INCORPORATED.			
REVISION HISTORY			
REV	DESCRIPTION	DATE	APPROVED
0	0	0	0
0.2		10/31/25	


0.2_M.1 Updated Frame Grounds to reflect as built. 01/21/26

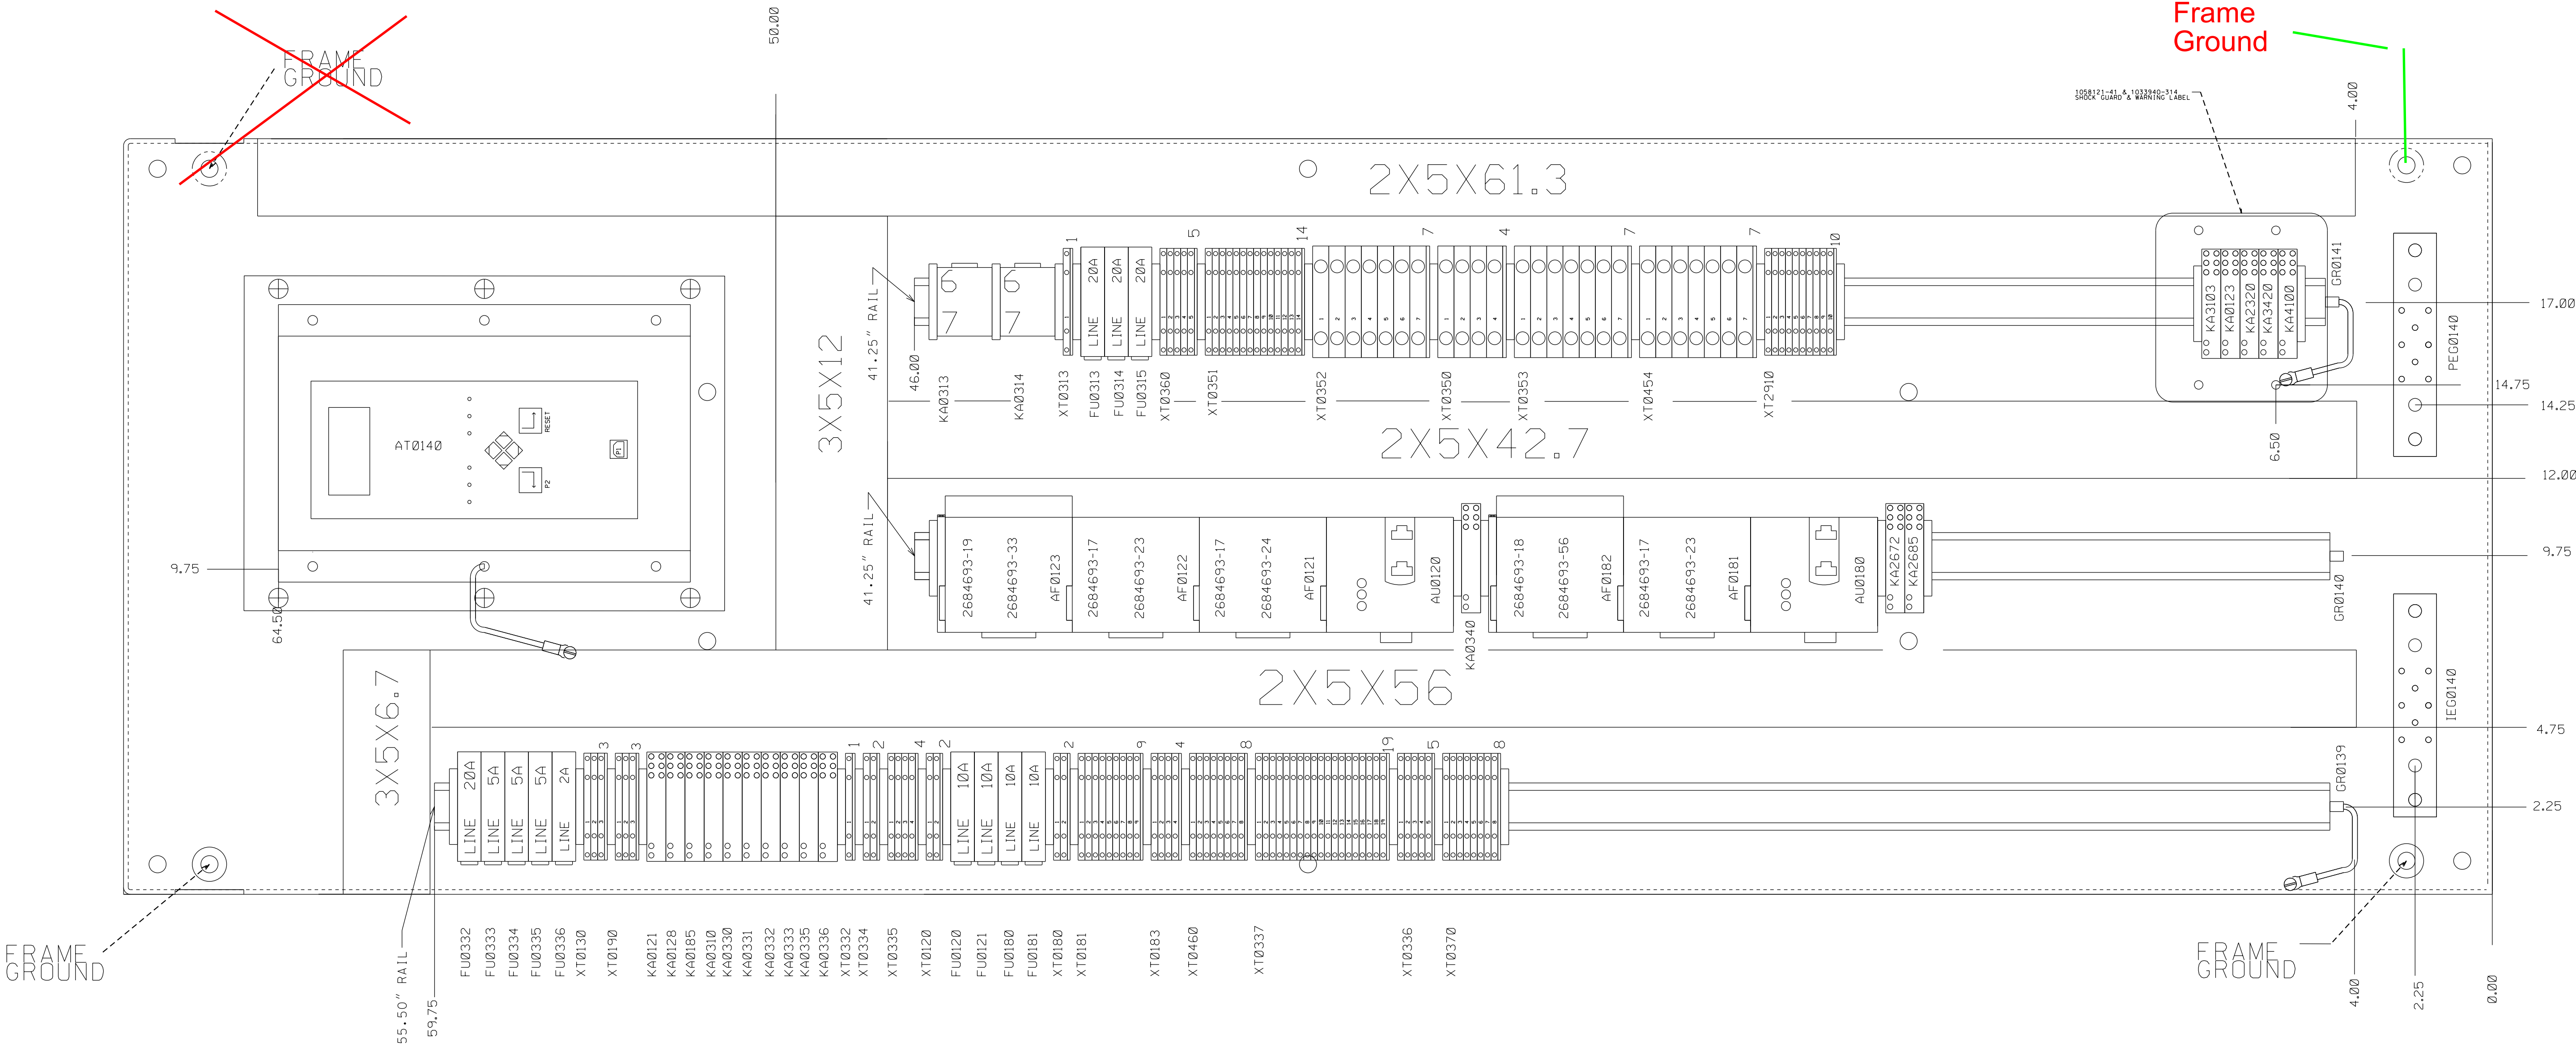

BOX : 1901271-4D741
PANEL : 1053331-501

CATERPILLAR CONFIDENTIAL GREEN						
THIS COPYRIGHTED WORK AND THE INFORMATION HEREIN IS PROPRIETARY TO CATERPILLAR INC., SOLAR TURBINES INCORPORATED, AND/OR SUBSIDIARIES OF EITHER. WITHOUT EXPRESS WRITTEN PERMISSION FROM CATERPILLAR INC. OR SOLAR TURBINES INCORPORATED, ANY COPYING, DISCLOSURE, OR USE EXCEPT THAT FOR WHICH IT IS LOANED, IS PROHIBITED.						
DATA CONTROL LEVEL 1	RELEASE STAMP PD- 4K391	SIZE D	CAGE NO. 66195		Solar Turbines <i>A Caterpillar Company</i> P.O. BOX 85376 San Diego, California 92186-5376	
		MFG DES ENGINEER	DATE	DRAWING TITLE GEN CMPNT		
			10/31/2025			
		DESIGN ENGINEER	DATE			
			10/31/2025			
PROJECT NAME Enterprise SMT130 M4 WTX				PANEL NO. 0		
MODEL	CTLM02 TURBOTRONICS 4			DWG NO. 4K391-2876532	SHT REV 0.0	
LOC	T:\PROJECT\LAYOUT\REV\			DWG REV 0.2	SHEET 13 OF 14	

7		8	
THIS PRINT IS PROVIDED ON A RESTRICTED BASIS AND IS NOT TO BE USED IN ANY WAY DETRIMENTAL TO SOLAR TURBINES INCORPORATED.			
REVISION HISTORY			
REV	DESCRIPTION	DATE	APPROVED
0	0	0	0
0.2		10/31/25	

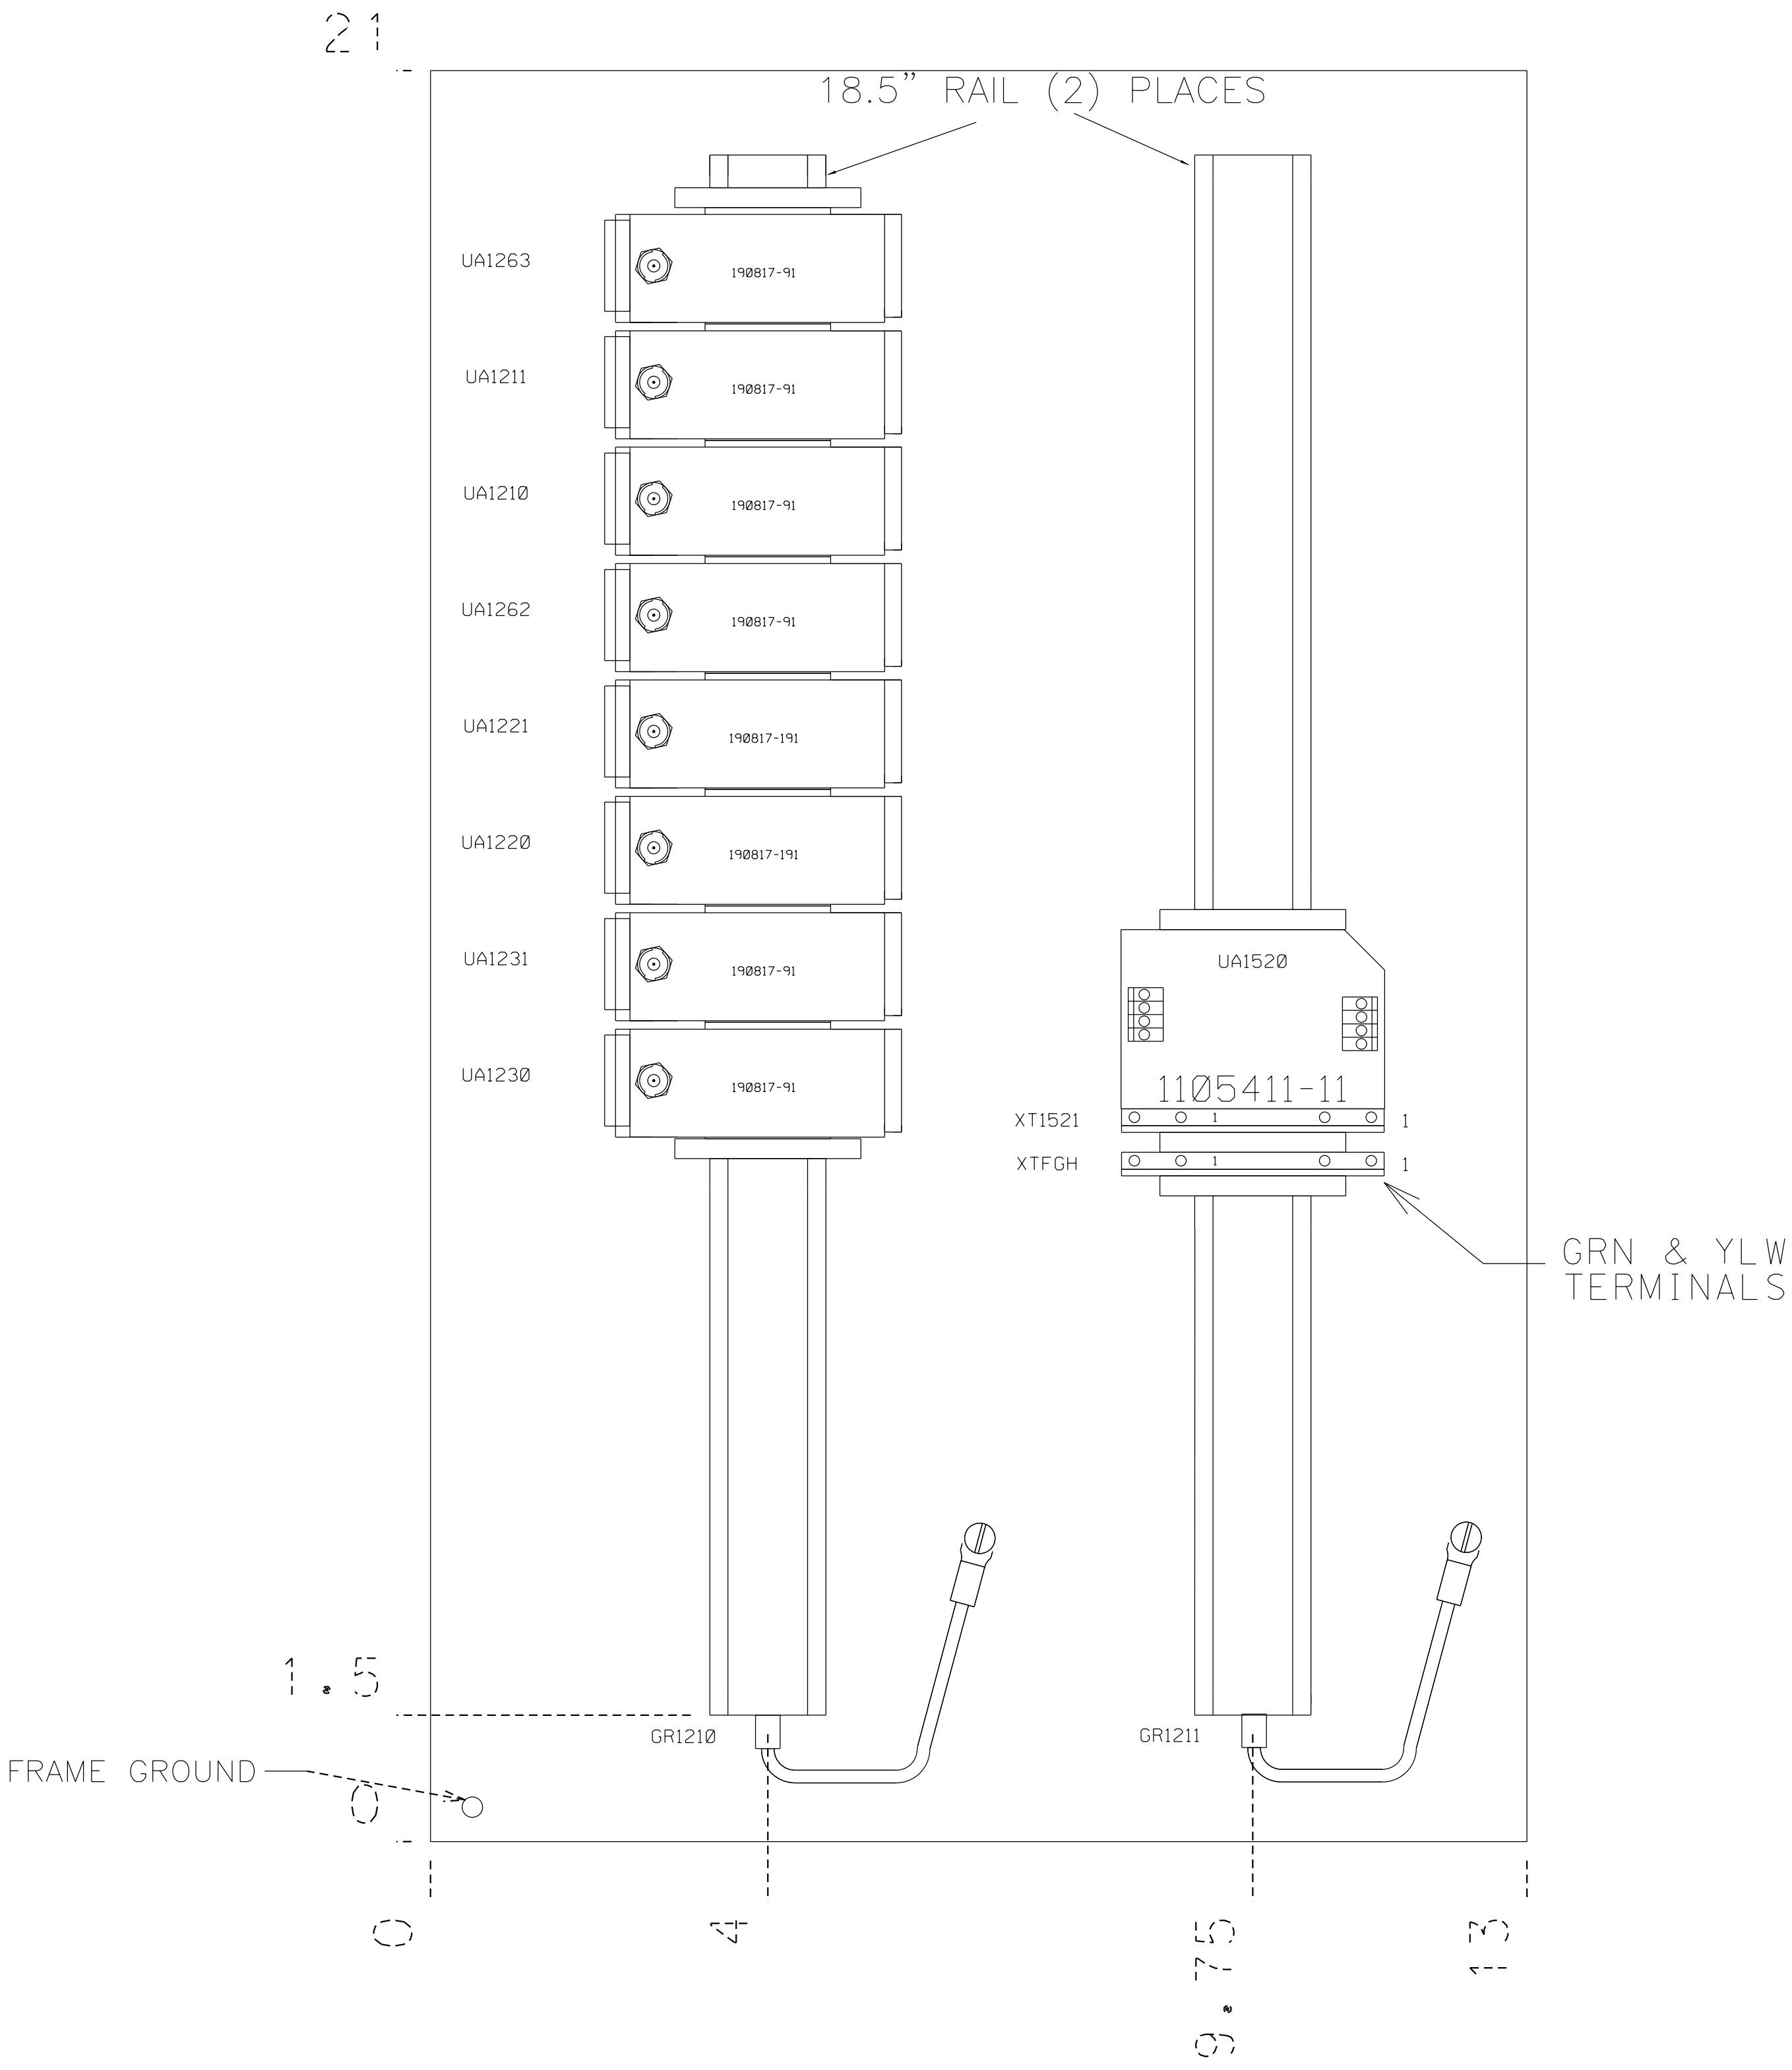

BOX P/N: 1059579-50

PANEL: 981070C1

CATERPILLAR CONFIDENTIAL GREEN						
THIS COPYRIGHTED WORK AND THE INFORMATION HEREIN IS PROPRIETARY TO CATERPILLAR INC., SOLAR TURBINES INCORPORATED, AND/OR SUBSIDIARIES OF EITHER. WITHOUT EXPRESS WRITTEN PERMISSION FROM CATERPILLAR INC. OR SOLAR TURBINES INCORPORATED, ANY COPYING, DISCLOSURE, OR USE EXCEPT THAT FOR WHICH IT IS LOANED, IS PROHIBITED.						
DATA CONTROL LEVEL 1	RELEASE STAMP PD- 4K391	SIZE	CAGE NO.		Solar Turbines <i>A Caterpillar Company</i>	P.O. BOX 85376 San Diego, California 92186-5376
		D	66195			
		MFG DES ENGINEER	DATE	DRAWING TITLE PROX,TURB		
			10/31/2025			
		DESIGN ENGINEER	DATE			
		10/31/2025				
PROJECT NAME Enterprise SMT130 M4 WTX				PANEL NO. 0		
MODEL	CTLM02 TURBOTRONICS 4			DWG NO.	4K391-2793099	SHT REV 0.0
LOC	T:\PROJECT\LAYOUT\REV\			DWG REV 0.2		SHEET 14 OF 14